

KANSAS


Russell

FORM 51 5M PETROL

Section 5 Township 15 Range 13-W

Well No. ~~#2 Gross~~ # 3 Gross "A"

Company R. H. Shields

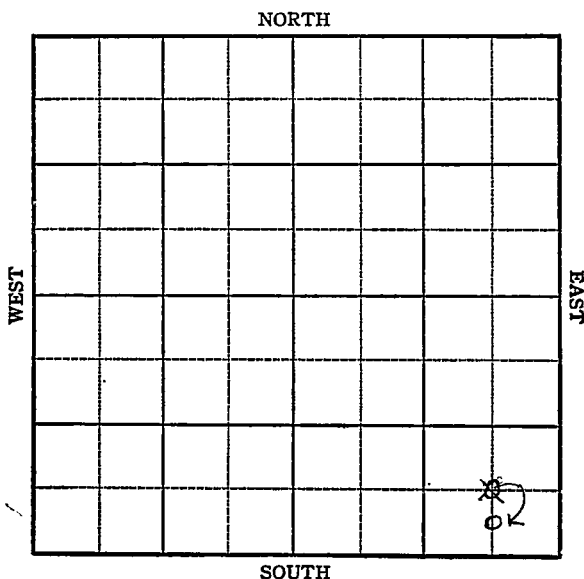


Sec. 5 Twp. 15 R. 13-W

Well No. ~~#2 Gross~~ # 3 Gross "A" Farm

R. H. Shields Company

NORTH

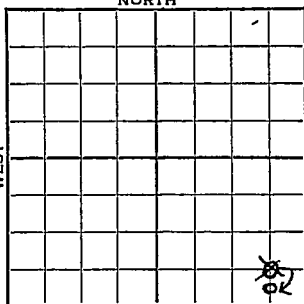

Ft. from N. Line

330

~~660~~ Ft. from S. Line

660 Ft. from E. Line

Ft. from W. Line

Elev. 1807

1943

REPORT

8/25	Cable Rig
9/1	" "
9/8	" "
9/15	" "
9/22	Spud
9/29	12" @ 405' 10" @ 785' Drlg. 975'
10/6	Anhy 775' Drlg. 2000'
10/13	8" @ 24;0 Topeka 2690 Drlg. 2715'
10/20	Lans 2983 Pay 3018-25 T.D. 7" @ 3003 WOC.

OVER

KANSAS
 Map No. 73 Sec. 5 Twp. 15 R. 13W

Well No. 2 Gross

R. H. Shields Company

CORRECTION Contractor

C S L SE SE

SECTION PLAT

_____ Ft. from N. Line

330 Ft. from S. Line

660 Ft. from E. Line

_____ Ft. from W. Line

			o

Hall-Gurney Pool

Location _____

Rig up _____

Drilling and Remarks:

Reported

C SE SE

RECORD

Cased _____ in., _____ ft.

Sand _____

Gas _____

Oil _____

Total Depth _____

PRODUCTION

1st 24 hrs. Nat. _____

1st 24 hrs. after shot _____

Gas _____ Cu. Ft.

Dry Hole _____

Abandoned _____

Date

SEP 1 1943 19

S. J. LEWIS Scout

Map No. KANSAS 3 Sec. 5 Twp. 15 R. 13W

Well No. 3 Gross "A"

R. H. Shields Company

CORRECTION Contractor

C S L SE SE

 Ft. from N. Line

330 Ft. from S. Line

660 Ft. from E. Line

 Ft. from W. Line

SECTION PLAT

			o

Hell-Gurney Pool

Location

Rig up

Drilling and Remarks:

Changed from #2 Gross

RECORD

Cased in., ft.

Sand

Gas

Oil

Total Depth

PRODUCTION

1st 24 hrs. Nat.

1st 24 hrs. after shot

Gas Cu. Ft.

Dry Hole

Abandoned

Date

OCT 27 1943

19

S. J. LEWIS

Scout

KANSAS

Map No. 73 Sec. 5 Twp. 15 R. 13WWell No. 3 Gross "A"R. H. Shields CompanyCOMPLETED Contractor

C S L SE SE

SECTION PLAT

 Ft. from N. Line330 Ft. from S. Line660 Ft. from E. Line Ft. from W. Line

Hall-Gurney PoolLocation Rig up

Drilling and Remarks:

*Lease 2983
7' @ 3003
5000 cu. ft.
Pump 315 Bx

39° Gr*

RECORD

Cased in., ft.Sand Gas Oil Total Depth 3080

PRODUCTION

1st 24 hrs. Nat. 1st 24 hrs. after shot Gas Cu. Ft.Dry Hole Abandoned

Date

OCT 27 1943 19 S. J. LEWIS Scout

1943

10/27 Lans 2983
7" @ 3003
5000 acid
Pump 315 Pot.
T.D. 3030'
Gravity 39

COMPLETED