


Section 36 Township 16 Range 12W

Well No. #2 Hoffman

Company Black-Marshall

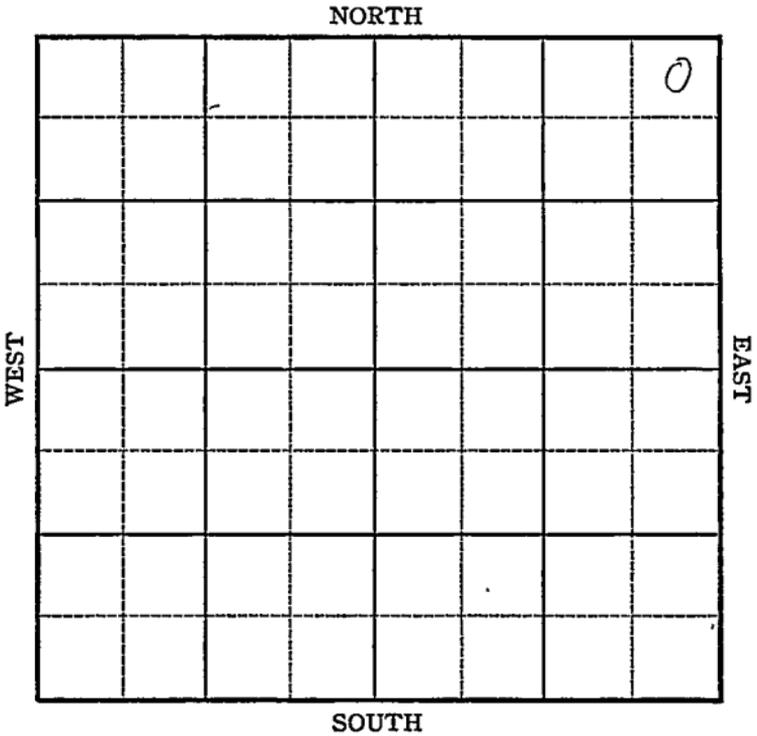

KANSAS
Sec. 36

Barton

Twp. 16

R. 12W

Well No. #2 Hoffman Farm

Black-Marshall Company

Beaver


330 Ft. from N. Line

_____ Ft. from S. Line

330 Ft. from E. Line

_____ Ft. from W. Line

Dec. 1899

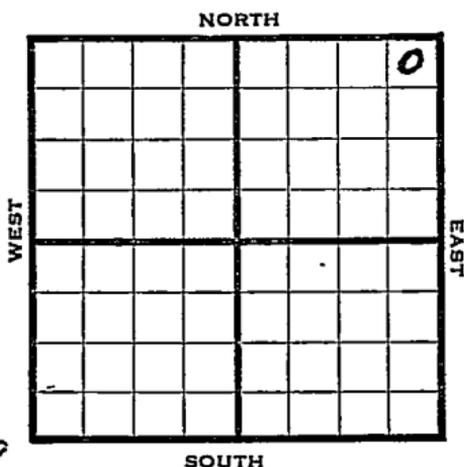

1944

R E P O R T

- 4/26 Location #1 in C of 40 acres.
- 5/3 Rig
- 5/10 Rigging up
- 5/17 Drlg. 205
- 5/24 12" @ 460
Anhy. 744
Drlg. 990
- 5/31 Drlg. 2010
- 6/7 10" @ 768
8" @ 2055 - 2425 UR 8"
- 6/15 8" @ 2675 2775 fishing
- 6/21 8" @ 2497
Drlg. 2550 Never Was 2775'
- 6/28 Lans 3052
7" ↓ 3173
Drlg 3200

OVER

1944

7/12 Gorham 3296
5" @ 3297
Pump 147 Pot
TD 3306
Gravity 36.8

COMPLETED

KANSAS

Pool Name BeaverMap No. 55 Sec. 36 Twp. 16 R. 12WWell No. 2 HoffmanBlack-Marshall Company

FIRST REPORT

Contractor

NE/C

SECTION PLAT

330 Ft. from N. Line

_____ Ft. from S. Line

330 Ft. from E. Line

_____ Ft. from W. Line

			o

Barton County

Location X

Rig up _____

Drilling and Remarks:

#1 in C of

40 acres

RECORD

Cased _____ in., _____ ft.

Sand _____

Gas _____

Oil _____

Total Depth _____

PRODUCTION

1st 24 hrs. Nat. _____

1st 24 hrs. after shot _____

Gas _____ Cu. Ft.

Dry Hole _____

Abandoned _____

Date

APR 26 1944 19

S. J. LEWIS Scout

Pool Name BeaverMap No. KANSAS Sec. 36 Twp. 16 R. 12WWell No. 2 HoffmanBlack-Marshall CompanyCOMPLETED Contractor

NE/C

SECTION PLAT

330 Ft. from N. Line

Ft. from S. Line

330 Ft. from E. Line

Ft. from W. Line

			o

Barton County

Location _____

Rig up _____

Drilling and Remarks:

*Boekam 3296**5" @ 3297**Pump 147 P.D.**36 E.H.*

RECORD

Cased _____ in., _____ ft.

Sand _____

Gas _____

Oil _____

Total Depth 3306

PRODUCTION

1st 24 hrs. Nat. _____

1st 24 hrs. after shot _____

Gas _____ Cu. Ft.

Dry Hole _____

Abandoned _____

Date

JUL 12 1944 19S. J. LEWIS Scout