


Section 5 Township 15 Range 13 W

Well No. # 1 Gross

Company Murphin

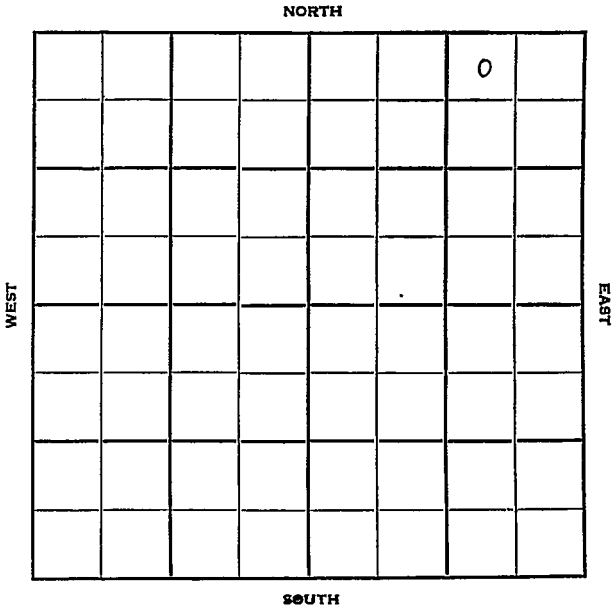

Russell

KANSAS

Sec. 5 Twp. 15 R. 13W 1

Well No. #1 Gross Farm

Murphin Company

Murfin Drlg. Contractor


Trapp Pool

330 Ft. from N. Line

990 Ft. from S. Line

         Ft. from E. Line

         Ft. from W. Line

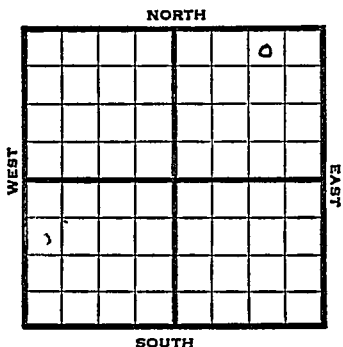

NW NE NE

1951

Elev. 1705' REPORT

11/7

Location

1952  
1/9

Spud 11-24-51

Oil well TD 2894' 15" @ 60

10" @ 657 Tarkio 2257' 8" @ 2355

Top 2560' Lans. 2891' 7" @ 2886

TD 2894' 5000 A S/240 BOPD

Comp. 100 BOPD

**COMPLETED**

County Russell State Kansas

Sec. 5 (Blk. Twp.) 15 (Sur. Rge.) 13W Map No.

Operator Murphin

Well No. 1 Farm Gross

Elev. \_\_\_\_\_ Location NW NE NE


330 Ft. From N Line NE

990 Ft. From E Line Quarter

Ist. Report NOV 7 1951

Completion \_\_\_\_\_

Remarks \_\_\_\_\_

Murphin - Contr.

Spudding Date \_\_\_\_\_

Drig. Data \_\_\_\_\_ Trapp

Location

J. E. TYRA

County Russell State KansasSec. 5 (Blk. Twp.) 15 (Sur. Rge.) 13W Map No.Operator Murfin Drlg.Well No. 1 Farm GrossElev. 1705 Location NW NE NE


330 Ft. From N Line NE990 Ft. From E Line Quarter

1st. Report

Completion JAN 9 1952Remarks Trapp PoolMurfin Drlg. - Contr.Spudding Date 11-24-51Drlg. Data Oil well TD 289415" @ 60 10" @ 657 Tarkio 22578" @ 2355 Top. 2560 Lans. 28917" @ 2886 TD 2894 5000 A S/ 240 bopdComp. 100 bopd

J. E. TYRA