


KANSAS

Russell

Section 4 Township 15 Range 13-W

Well No. #4 Letsch "A"

Company Stanolind

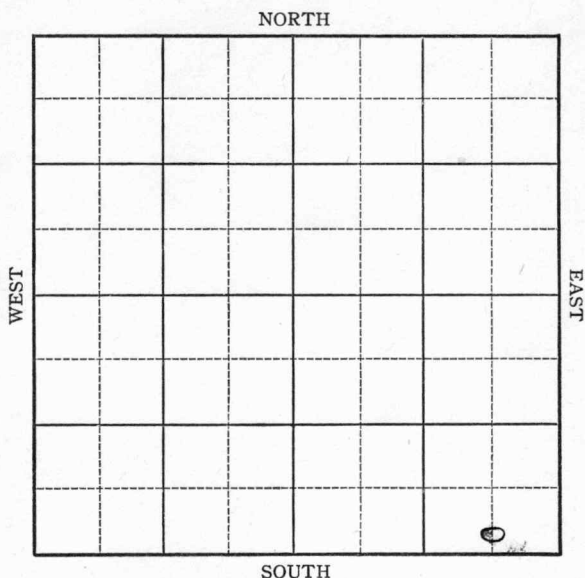

KANSAS

Russell

Sec. 4 Twp. 15 R. 13-W

Well No. #4 Letsch "A" Farm

Stanolind Company

Hall-Gurney
Pool


 Ft. from N. Line

330 Ft. from S. Line

660 Ft. from E. Line

 Ft. from W. Line

Elev. 1809

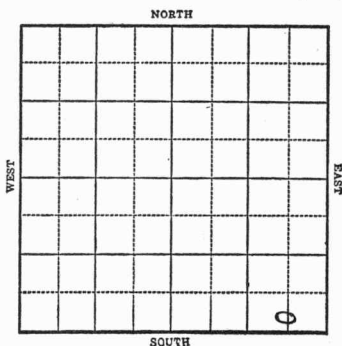

1943

R E P O R T

4/7 Pits
4/14 Rotary
4/21 8" @ 521 WOC.
4/28 Arb 760'
Drlg. 2550'
5/5 Topeka 2680
Lans 2974
Drlg. 3226SO
5/12 Congl 3241
Arb 3285
T.D. 3314
5" @ 3150 Rust.
5/19 Lans. 2974
5" - 3150
94 shots 3000-20
3000 acid
Pump 548 Pot.
T.D. 3314
Gravity 39.

COMPLETED

Russell

KANSAS

Map No. 73 Sec. 4 Twp. 15 R. 13WWell No. 4 Letsch "A"Stanolind


Company

FIRST REPORT

Contractor

C SL SE SE

SECTION PLAT

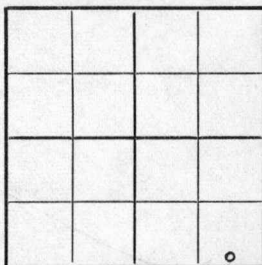 Ft. from N. Line330 Ft. from S. Line660 Ft. from E. Line Ft. from W. LineHALL-GURNEY POOLLocation Rig up

Drilling and Remarks:

Pits

RECORD

Cased in., ft.Sand Gas Oil Total Depth

PRODUCTION

1st 24 hrs. Nat. 1st 24 hrs. after shot Gas Cu. Ft.Dry Hole Abandoned

Date

APR 7 1943 19 S. J. LEWIS Scout


KANSAS

Russell

Map No. 73 Sec. 4 Twp. 15 R. 13WWell No. 4 Letsch "A"Stanolind CompanyCOMPLETED Contractor

C S L S E S E

SECTION PLAT

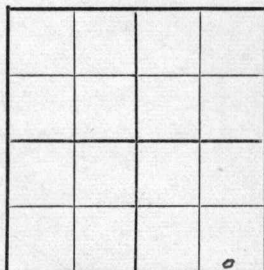 Ft. from N. Line330 Ft. from S. Line660 Ft. from E. Line Ft. from W. Line

HALL-GURNEY POOL

Location Rig up

Drilling and Remarks:

Lease 29745" @ 815094 shot to 3000-203000 acidPump 548 B.D.39° G

RECORD

Cased in., ft.Sand Gas Oil Total Depth 3314

PRODUCTION

1st 24 hrs. Nat. 1st 24 hrs. after shot Gas Cu. Ft.Dry Hole Abandoned

Date

MAY 19 194319S. J. LEWIS Scout