


KANSAS

Section 4 Township 16 Range 13W

Well No. #1 Schultz

Company Crown Oil Co.

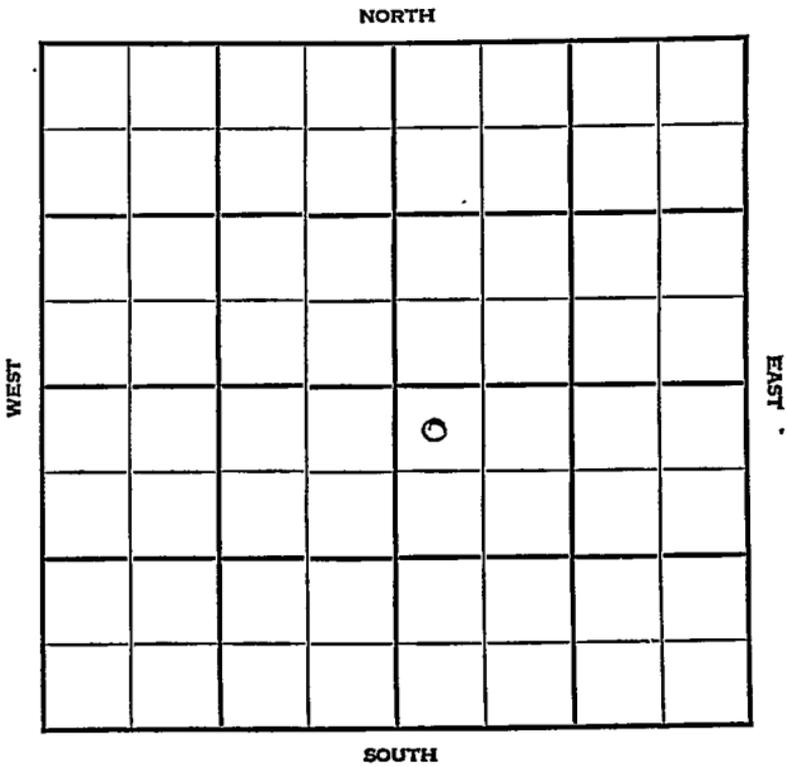



Sec. 4 Twp. 16 R. 13W

Well No. #1 Schultz Farm

Crown Oil et al Company


Trapp

330 Ft. from N. Line

_____ Ft. from S. Line

_____ Ft. from E. Line

330 Ft. from W. Line

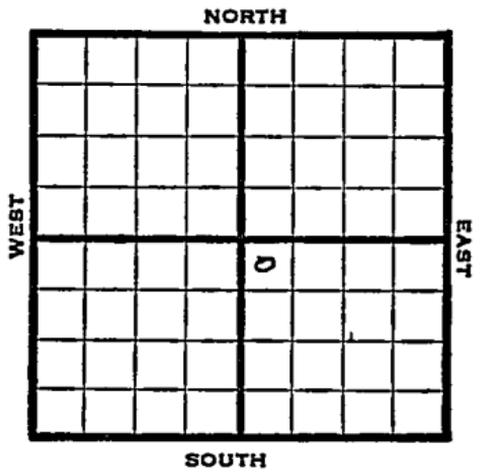

NW SE

1947	Elev. 1910' REPORT
12/3	RUR
12/10	8" @ 256' Anhydrite 869' Drlg. 1575'
12/23	Arb. 3389' TD 3430'
	ABANDONED

Map No. _____ Sec. 4 Twp. 16 R. 13W

Well No. 1 Schultz

Crown Oil et al. Company

FIRST REPORT

Contractor

NW SE


SECTION PLAT

330 Ft. from N. Line

_____ Ft. from S. Line

_____ Ft. from E. Line

330 Ft. from W. Line

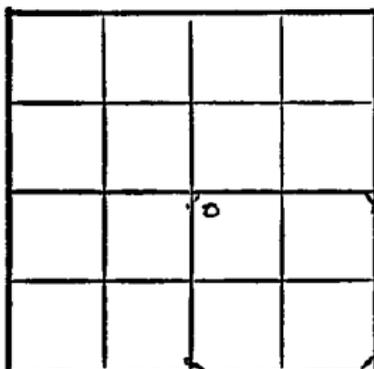

Barton County

Location _____

Rig up _____

Drilling and Remarks:

R U R

RECORD

Cased _____ in., _____ ft.

Sand _____

Gas _____

Oil _____

Total Depth _____

PRODUCTION

1st 24 hrs. Nat. _____

1st 24 hrs. after shot _____

Gas _____ Cu. Ft.

Dry Hole _____

Abandoned _____

Date

DEC 3 1947 19 S. J. LEWIS Scout

