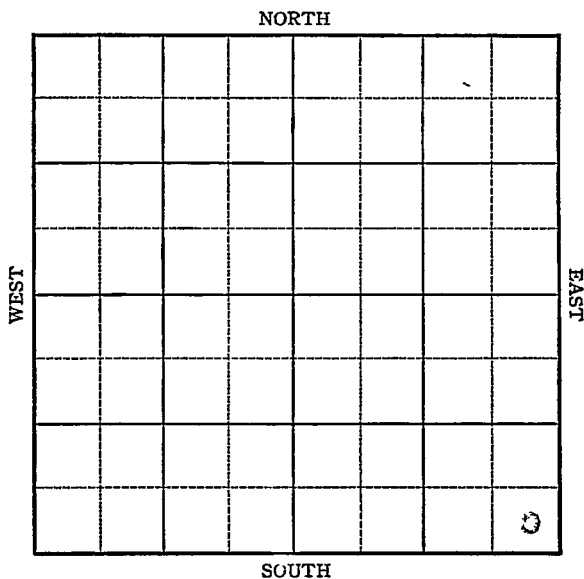


Section 3 Township 15S Range 14WWell No. #1 W. R. KrugCompany ~~Pryor & Lockhart~~ Co-op

KANSAS

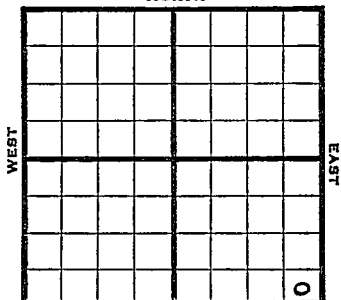
Russell

Sec. 3 Twp. 15 R. 14WWell No. #1 W.R. Krug Farm~~Pryor & Lockhart~~

Company

Trapp

NORTH

 Ft. from N. Line330 Ft. from S. Line330 Ft. from E. Line Ft. from W. LineSE/c Edw-1737

SOUTH

1945	R E P O R T
3/21	Rig
3/29	Rigging up cable
4/5	Anhy 746 10" @ 749 WOO
4/12	988' Recement csg.
4/20	10" @ 749' Drlg. 1565
4/27	2183' fsg.
5/3	Tarkio 2322-2385
5/10	2575' UR 8"
5/17	8" @ 2580 Dedge 2893 SO Drlg. 2940
5/24	Lans 2957 7" @ 2969
5/31	Drlg. 3150' 7" @ 3155 Arb 3201 Drlg. 3206
6/13	Lams 2957 Arb 3201 Perf Lams 5000 acid Pump 434 Pot. 41 O Gr. TD 3226'
	COMPLETED

Pool Name TrappMap No. 73 Sec. 3 Twp. 15 R. 14WWell No. 1 W. R. KrugPryor & Lockhart

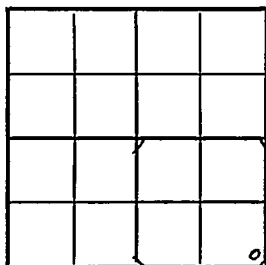
Company

FIRST REPORT

Contractor

SE/c

SECTION PLAT

 Ft. from N. Line330 Ft. from S. Line330 Ft. from E. Line Ft. from W. LineRussell CountyLocation Rig up

Drilling and Remarks:

rig

RECORD

Cased in., ft.Sand Gas Oil Total Depth

PRODUCTION

1st 24 hrs. Nat. 1st 24 hrs. after shot Gas Cu. Ft.Dry Hole Abandoned

Date

MAR 21 1945

19

S. I. LEWIS

Scout

Kansas Pool Name TrappMap No. 13 Sec. 3 Twp. 15 R. 14WWell No. 1 W. R. KrugCo-op

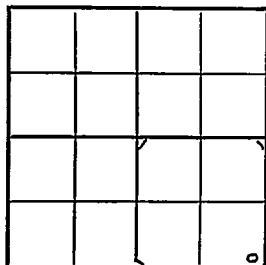
Company

CORRECTION

Contractor

SE/c

SECTION PLAT

 Ft. from N. Line330 Ft. from S. Line330 Ft. from E. Line Ft. from W. LineRussellLocation Rig up

Drilling and Remarks:

was ~~Ray~~ or and
 Lockhart bought
 out by Co-op.

RECORD

Cased in., ft.Sand Gas Oil Total Depth

PRODUCTION

1st 24 hrs. Nat. 1st 24 hrs. after shot Gas Cu. Ft.Dry Hole Abandoned

Date

MAY 2 1945

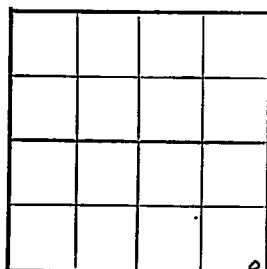
19

S. J. LEWIS

Scout

KansaPool Name TrappMap No. 73 Sec. 3 Twp. 15 R. 14WWell No. 1W. R. KrugCo-op Company**COMPLETED**SE/c ContractorE 1/1937

SECTION PLAT

 Ft. from N. Line330 Ft. from S. Line330 Ft. from E. Line Ft. from W. LineRussell CountyLocation Rig up

Drilling and Remarks:

Lane 2957Ar 832015" @ 320 ftPerf Lane.5000 AcidPump 434 ft412 ft

RECORD

Cased in., ft.Sand Gas Oil Total Depth 3226

PRODUCTION

1st 24 hrs. Nat. 1st 24 hrs. after shot Gas Cu. Ft.Dry Hole Abandoned

Date

JUN 13 194519S. J. LEWISScout