


35-K65 DRL

Section 30 Township 16 Range 12 W

Well No. #1 Korkisch

Company Shields Oil Producers

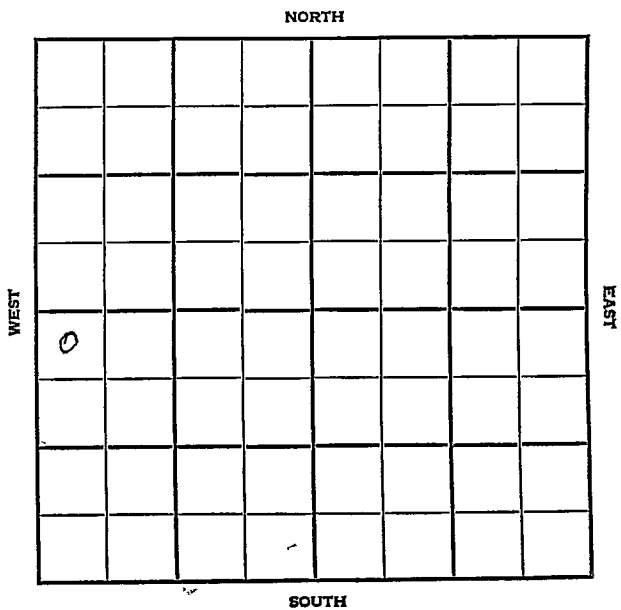

Barton

KANSAS

SEC.	25-K61 36 DRL	TWP.	16	R.	12W
------	------------------	------	----	----	-----

WELL NO. #1 Korisch FARM

COMPANY Shields Oil Producers

CONTRACTOR


Kraft-Prusa

_____ Ft. from N. Line

_____ Ft. from S. Line

_____ Ft. from E. Line

_____ Ft. from W. Line

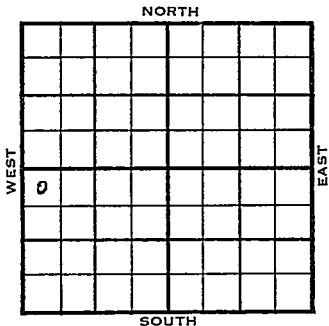

NW NW SW

	ELEVATION	REPORT
--	-----------	--------

1955

1903'

9/28

C & P

10/19

Comm 9-30-55

8 5/8" @ 202/150

H 2988

B1 3079

L 2095

Cong sd 3363

Chert 3366

TD 3390

DST 2995-3115 open 1 hr rec 62' mud

930# DST 3118-67 open 1 hr rec

1040' wtr 960#

D & A

ABANDONED

County Boston Elev. 1903
 Sec. 3635 K65 D&L 16 Rgs. 12W
 Company Shields Oil Prod.
 Farm Name Korkisch No. 1

TOPS	DEPTH	LOG	DATUM
Anh.			
TP.			
H.	<u>2988</u>		<u>1085</u>
Tr.			
Dg.			
Bl.	<u>3079</u>		<u>1176</u>
L.	<u>3075</u>		<u>1192</u>
K.C.			
B.K.C.			
Ge. <u>Congad</u>	<u>3363</u>		<u>1460</u>
C. <u>Chert</u>	<u>3366</u>		<u>1463</u>
M.			
M.			
K.			
Mz.			
Ma.			
V.			
S.			
S.			
A.			
R.			
Pe.			
G.			
TD.	<u>3390</u>		

Loc. in Sec. NW NW SW
 Geol. _____
 Contr. _____
 Pool Kraft-Prusa

ABANDONED

Date Comm. 9-30-55 OCT 19 1955
8 5/8" @ 202/150 DST 2995-3115
open 1 hr. rec. 62' mud 930#
DST 3118-67 open 1 hr. rec. 1040'
wtr. 960#

D & A

Co.
 Lse.
 No.
 Sec.
 T.
 R.