


Section 36 Township 16 Range 12W

Well No. #1 Reimann

Company Duke & Wood

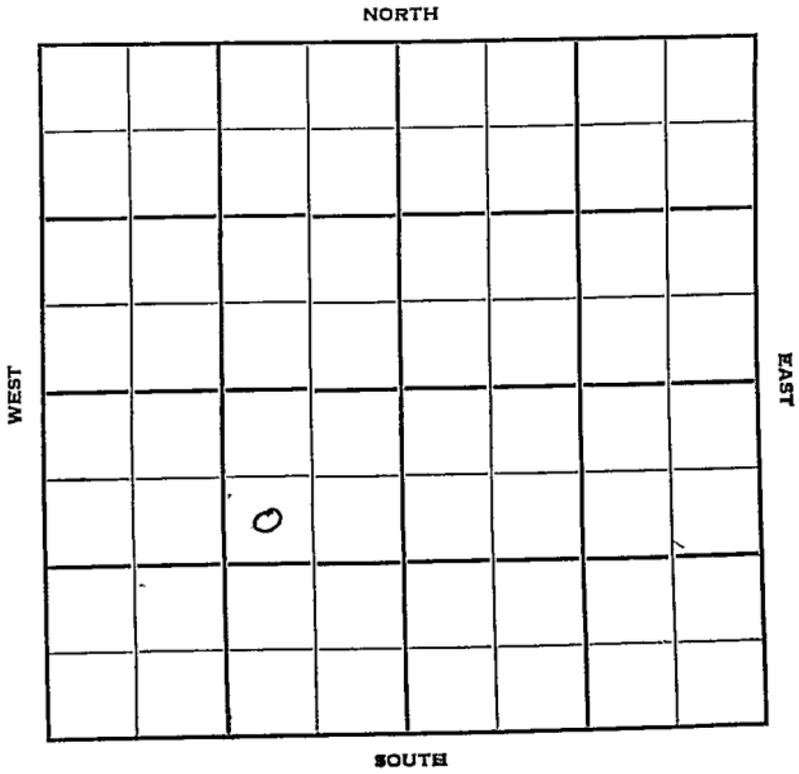

Sec. 36 Twp. 16 R. 12W

Well No. #1 Reimann Farm

Duke & Wood Company

Duke & Wood Contractor

Semi Wildcat


990 Ft. from N. Line

_____ Ft. from S. Line

990 Ft. from E. Line

_____ Ft. from W. Line

SW NE SW

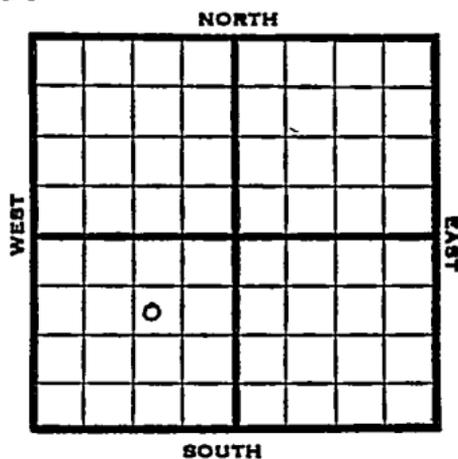

1952

Elev. 1895' REPORT

11/12 Spud 11-4-52
8" @ 294'
Anhy 762
Drlg. 2914'

11/19 Spud 11-4-52
D & A TD 3374' 8" @ 294'
Anhy 762' Heeb 2978' Dodge 2996'
Br. line 3077' Lans. 3094'
DST 3118-40 open 35 min rec 7' mud
0# Cong. 3349' TD 3374'
D & A

ABANDONED

