

KANSAS

Russell


Form 51-5M-7-39-Palace

Section 5 Township 15 Range 13-W

Well No. #1 Gross

Company M. E. Trapp

NORTH Coralena Pool

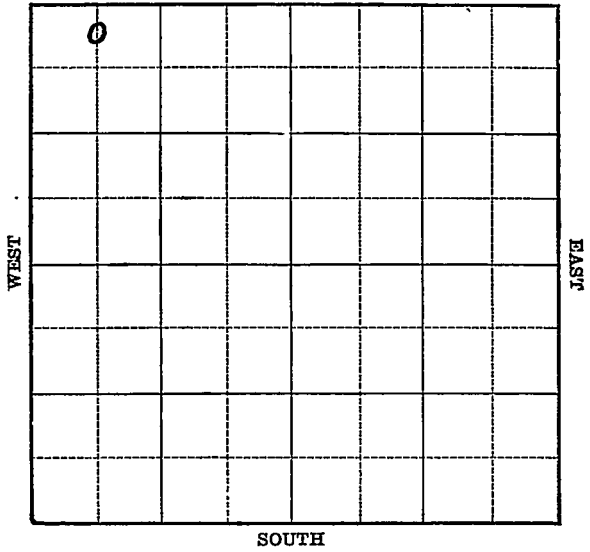

1940

6/5

Lans. 2873'

7" - 2875 $\frac{1}{2}$ '

T.D. 2918'

60 shots 2855-60'

8000 acid.

Potential 2150 bbls., pump.

COMPLETED

Map No. _____ Sec. 5 Twp. 15 R. 13W

Well No. 1 Gross

M. E. Trapp Company

£ Contractor

FIRST REPORT

C N $\frac{1}{2}$ NW NW

660 Ft. from N. Line

_____ Ft. from S. Line

_____ Ft. from E. Line

330 Ft. from W. Line

SECTION PLAT

0			

CORALENA POOL

Location _____

Rig up _____

Drilling and Remarks:

Cellar

RECORD

Cased _____ in., _____ ft.

Sand _____

Gas _____

Oil _____

Total Depth _____

PRODUCTION

1st 24 hrs. Nat. _____

1st 24 hrs. after shot _____

Gas _____ Cu. Ft.

Dry Hole _____

Abandoned _____

Date

FEB 28 1949

S. J. LEWIS Scout



Your drilling report shows this well in C N/2 NW NW and this ticket shows well in C W/2 NW NW.

Please check and advise.

Paul.

Misc Small Maps	<i>[Signature]</i>
Cards	<i>[Signature]</i>
Tracing	<i>[Signature]</i>
France Map	<i>[Signature]</i>
Scarborough Map	<i>[Signature]</i>
Moody Map	<i>[Signature]</i>
Geological Dept.	
Moody Flat Book	



6-200 Bks.—1-40—Palace

Russell KANSAS

Map No. 73 Sec. 5 Twp. 15 R. 13W

Well No. 1 GROSS

M. E. Trapp Company

CORRECTION Contractor

SECTION PLAT

C N $\frac{1}{2}$ NW NW
330 Ft. from N. Line
_____ Ft. from S. Line
_____ Ft. from E. Line
660 Ft. from W. Line

o			

CORALENA POOL

Location _____

Rig up _____

Drilling and Remarks:

**Shown spotted
wrong**

RECORD

Cased _____ in., _____ ft.

Sand _____

Gas _____

Oil _____

Total Depth _____

PRODUCTION

1st 24 hrs. Nat. _____

1st 24 hrs. after shot _____

Gas _____ Cu. Ft.

Dry Hole _____

Abandoned _____

Date

MAR 6 1940
19

S. J. LEWIS Scout

Map No. 73 Sec. 5 Twp. 15 R. 13W

Well No. 1 GROSS

M. E. Trapp Company

Contractor

COMPLETED

SECTION PLAT

C $N\frac{1}{2}$ NW NW

330 Ft. from N. Line

_____ Ft. from S. Line

_____ Ft. from E. Line

660 Ft. from W. Line

o			

GORALENA POOL

Location _____

Rig up _____

Drilling and Remarks:

Lans. 2873
5" C 2875 1/2
60 skts. 2855-60
8000 acid
Pump 2150 P.S.

RECORD

Cased _____ in., _____ ft.

Sand _____

Gas _____

Oil _____

Total Depth 2918

PRODUCTION

1st 24 hrs. Nat. _____

1st 24 hrs. after shot _____

Gas _____ Cu. Ft.

Dry Hole _____

Abandoned _____

Date

JUN 5 1940 19

S. J. LEWIS Scout