


Cowley

Map No. None Sec. 30 Twp. 30 R. 3E

Well No. 1 Beurwanger Farm  
Lyle & Hamrick Company

NORTH

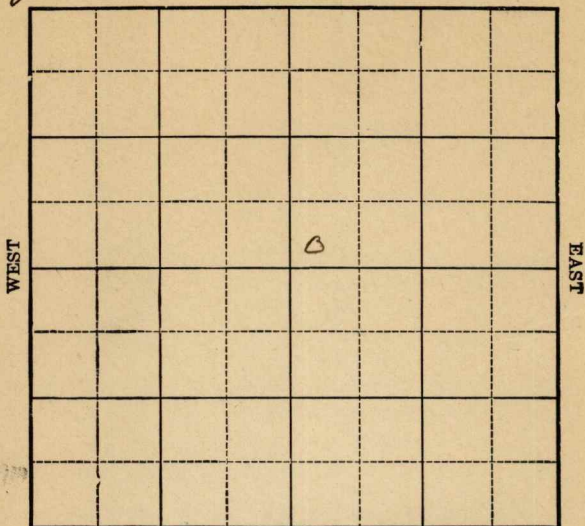

SOUTH

Location \_\_\_\_\_

Drilling Remarks \_\_\_\_\_  
\_\_\_\_\_  
\_\_\_\_\_  
Rig Up \_\_\_\_\_

Drilling Remarks \_\_\_\_\_  
\_\_\_\_\_  
\_\_\_\_\_  
RECORD

Cased \_\_\_\_\_ in. \_\_\_\_\_ ft.

Sand \_\_\_\_\_

Gas \_\_\_\_\_

Oil \_\_\_\_\_

Total Depth \_\_\_\_\_

PRODUCTION

1st 24 hrs. Nat. \_\_\_\_\_

1st 24 hrs. after shot \_\_\_\_\_

Gas \_\_\_\_\_ cu. ft.

Dry Hole \_\_\_\_\_

Abandoned \_\_\_\_\_

Cowley

Map No. 500 Sec. 30 Twp. 30 R. 3E


Well No. 1 Beirwanger Farm  
Pyle & Hamrick Company

Ft. from N. Line

300 Ft. from S. Line

Ft. from E. Line

300 Ft. from W. Line

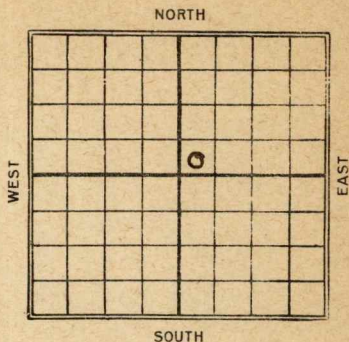

1926

Date	REPORT
9/22	Location
9/29	same
10/6	same
10/13	same
10/20	same
10/27	Spud & S.O.
11/3	same
11/10	Rigging up
11/17	Spud
11/24	Drlg 620
12/1	" 900
12/8	" 1575'
12/15	T.D. 1725' fishing tools
12/21	Drlg 1975
12/29	" 2100
1927	
1/5	Drlg 2300
1/12	" 2620
1/19	Run 8" @ 2760
1/26	Drilling 2955
2/2	Top line 3210 - drlg 3265
2/9	Drilling 3390

2/16 - Topline 3155 - S.L.M.  
Base 3470  
Wilcox 3545 - H.F.W.  
Total depth 3588

2/23 - T.D. 3604  
D & A

12 *Cowley*  
Map No. **KANSAS** Sec. *30* Twp. *30* R. *3E*

Well No. *1 Beiswanger*

*Pyle & Hamrick* Company

Contractor

SECTION PLAT

		o	

----- Ft. from N. Line

*300* Ft. from S. Line

----- Ft. from E. Line

*300* Ft. from W. Line

FIRST REPORTS

Location -----

Rig up -----

Drilling and Remarks:

*Location.*

RECORD

Cased ----- in., ----- ft.

Sand -----

Gas -----

Oil -----

Total Depth -----

PRODUCTION

1st 24 hrs. Nat. -----

1st 24 hrs. after shot -----

Gas ----- Cu. Ft.

Dry Hole -----

Abandoned -----

Date

SEP 22 1926

S. J. LEWIS

Scout

12 ~~Courtesy~~ KANSAS Map No. Sec 30 Twp. 30 R. 3E

Well No. 1 Beiswanger

Pyle & Hancock Company

Contractor

SECTION PLAT

----- Ft. from N. Line

300 Ft. from S. Line

----- Ft. from E. Line

300 Ft. from W. Line

		o	

ABANDONED

Location -----

Rig up -----

Drilling and Remarks:

T 3604

J & A.

RECORD

Cased ----- in., ----- ft.

Sand -----

Gas -----

Oil -----

Total Depth -----

PRODUCTION

1st 24 hrs. Nat. -----

1st 24 hrs. after shot -----

Gas ----- Cu. Ft.

Dry Hole -----

Abandoned -----

Date

FEB 23 1927

192

S. J. LEWIS

Scout

Butler

K12  
MAP NO. **KANSAS** SEC. 30 TWP. 30S R. 3E

WELL No. Beiswenger  
Pipe + Helmerick COMPANY

CONTRACTOR

SECTION PLAT

ABANDONED

		0	

\_\_\_\_\_ FT. FROM N. LINE

ABANDONED

\_\_\_\_\_ FT. FROM S. LINE

\_\_\_\_\_ FT. FROM E. LINE

\_\_\_\_\_ FT. FROM W. LINE

LOCATION \_\_\_\_\_

RIG UP \_\_\_\_\_

DRILLING AND REMARKS:

3604

RECORD

CASED \_\_\_\_\_ IN. \_\_\_\_\_ FT.

SAND \_\_\_\_\_

GAS \_\_\_\_\_

OIL \_\_\_\_\_

TOTAL DEPTH 3588

PRODUCTION

1ST 24 HRS. NAT. \_\_\_\_\_

1ST 24 HRS. AFTER SHOT \_\_\_\_\_

GAS \_\_\_\_\_ CU. FT.

DRY HOLE

ABANDONED

DATE

2/16 192 9

SCOUT