


Section 5 Township 15 Range 13-w

Well No. #1 Gross

Company R. H. Shields

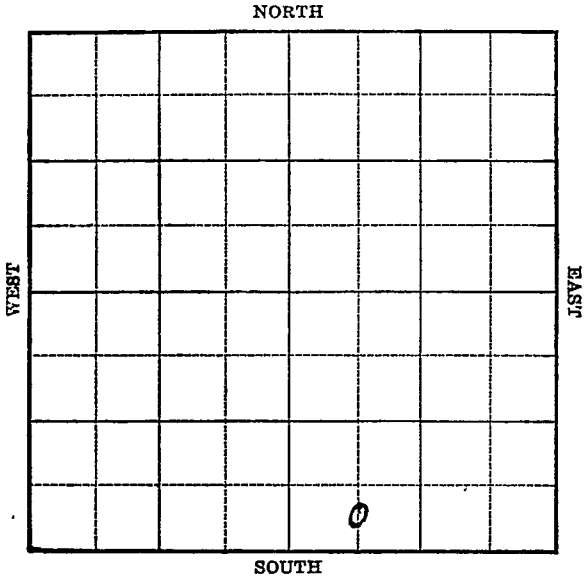

Sec. 5 Twp. 15 R. 13-W

Well No. #1 Gross Farm


R. H. Shields Company

\_\_\_\_\_ Ft. from N. Line

330 Ft. from S. Line

\_\_\_\_\_ Ft. from E. Line

660 Ft. from W. Line

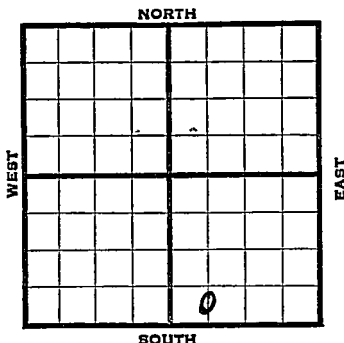

1938	REPORT
12/13	C. R.
12/23	Spud.
12/30	15" - 230'. Drlg. 645'.
1939	
1/6	Anhy. 698'. 10" - 710'. Drlg. 1685'.
1/13	8" - 2422'. C.O.
1/20	Dodge 2878'. S.S.O. & W. 2883'. Lans. 2932'. 7" - 2932'. T. D. 2970'. 1 bailer water. SD repairs.
1/27	Will P. B. to Lans.
2/3	T. D. 2976'. H.F.W. P. B. 2950'. Rng. 7".
2/10	7" - 2932'. P. B. to 2900'. Perf. 60 shots 2870-86'. 5 bbls. oil & S.W.
2/17	P.B. to 2900'. S.D.O.
2/23	1000 acid.

**OVER**

Russell KANSAS

Map No. 73 Sec. 5 Twp. 15 R. 13WWell No. 1 GrossR. H. Shields

Company

Contractor

## FIRST REPORT

C S L SW SE

\_\_\_\_\_ Ft. from N. Line

330 Ft. from S. Line

\_\_\_\_\_ Ft. from E. Line

660 Ft. from W. Line

## SECTION PLAT

		0	

Location \_\_\_\_\_

Rig up \_\_\_\_\_

Drilling and Remarks:

CR

## RECORD

Cased \_\_\_\_\_ in., \_\_\_\_\_ ft.

Sand \_\_\_\_\_

Gas \_\_\_\_\_

Oil \_\_\_\_\_

Total Depth \_\_\_\_\_

## PRODUCTION

1st 24 hrs. Nat. \_\_\_\_\_

1st 24 hrs. after shot \_\_\_\_\_

Gas \_\_\_\_\_ Cu. Ft.

Dry Hole \_\_\_\_\_

Abandoned \_\_\_\_\_

Date

DEC 13 1938

19

H. D. Hatfield

Scout

Russell

KANSAS

Map No. \_\_\_\_\_ Sec. 5 Twp. 15 R. 13W

Well No. 1 Gross

R. H. Shields

Company

Contractor

**COMPLETED**

**SECTION PLAT**

C S L SW SE

\_\_\_\_\_ Ft. from N. Line

330 Ft. from S. Line

\_\_\_\_\_ Ft. from E. Line

660 Ft. from W. Line

		0	

WILDCAT

Location \_\_\_\_\_

Rig up \_\_\_\_\_

Drilling and Remarks;

*P.B. 2885*  
*3000 Acid (Total)*

*Pot 603*

**RECORD**

Cased 7 in., 2932 ft.

~~Sand~~ *Dodge 2878*

Gas *LANS 2932*

Oil \_\_\_\_\_

Total Depth 2976 *HFW*

**PRODUCTION**

1st 24 hrs. Nat. \_\_\_\_\_

1st 24 hrs. after shot \_\_\_\_\_

Gas \_\_\_\_\_ Cu. Ft.

Dry Hole \_\_\_\_\_

Abandoned \_\_\_\_\_

Date

MAR 1 - 1939

19

H. D. Hatfield

Scout

1939

3/1

7" - 2932'

Dodge 2878'

Lans. 2932'

T. D. 2976' H.F.W.

P. B. to 2885'

3000 acid (total)

Potential 603 bbls.

COMPLETED