


Section 31 Township 30 Range 3-E

Well No. 1 Backus

Company C. I. Ross

NORTH Wildcat

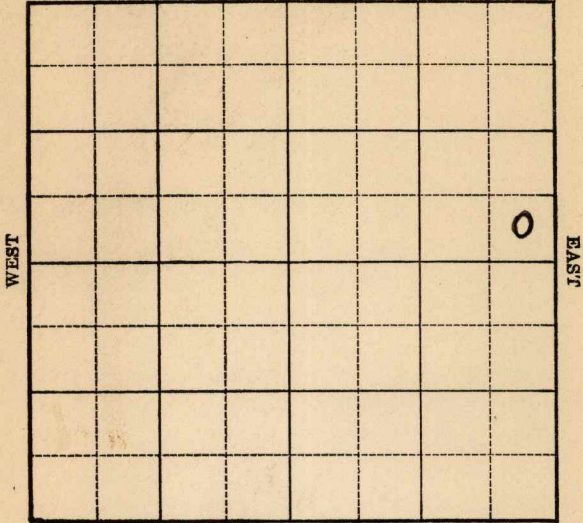

SOUTH

Cowley

KANSAS

Map No. 12 Sec. 31 Twp. 30 R. 3E

Well No. 1 Backus

C. I. Ross Company

Contractor

FIRST REPORT

SE NE

 Ft. from N. Line

330 Ft. from S. Line

330 Ft. from E. Line

 Ft. from W. Line

SECTION PLAT

			0

WILDCAT

Location

Rig up

Drilling and Remarks:

Mach.

RECORD

Cased in., ft.

Sand

Gas

Oil

Total Depth

PRODUCTION

1st 24 hrs. Nat.

1st 24 hrs. after shot

Gas Cu. Ft.

Dry Hole

Abandoned

Date

DEC 21 1938 19 H. D. Hatfield Scout

