

KANSAS


FORM 51 5M 1-42 PETROL

Barton

Section 36 Township 16 Range 12-W

Well No. #1 Seyfert

Company Black-Marshall

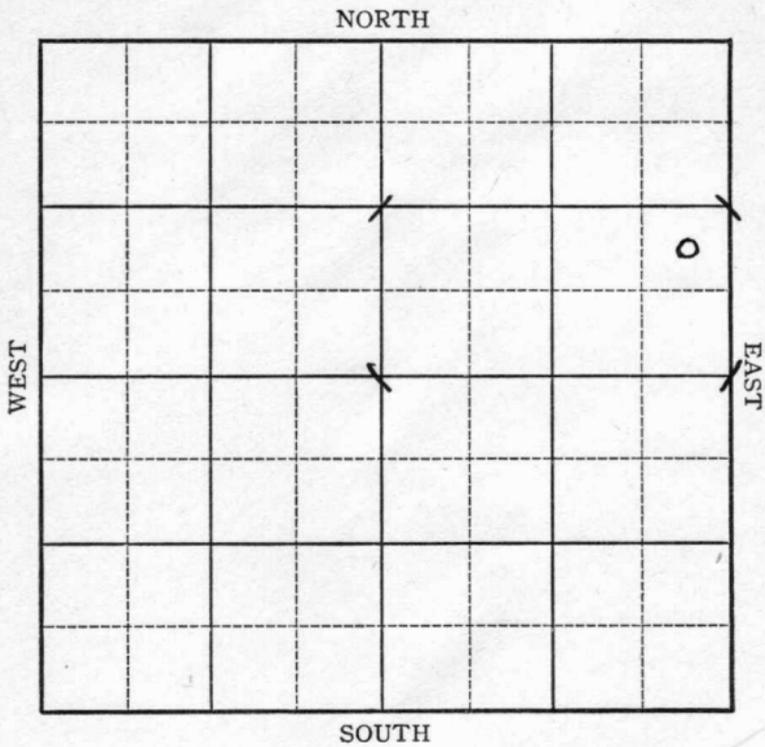

Sec. 36 Twp. 16 R. 12-W

Well No. #1 Seyfert Farm  
Black-Marshall Company


Beaver

           Ft. from N. Line

990 Ft. from S. Line

330 Ft. from E. Line

           Ft. from W. Line

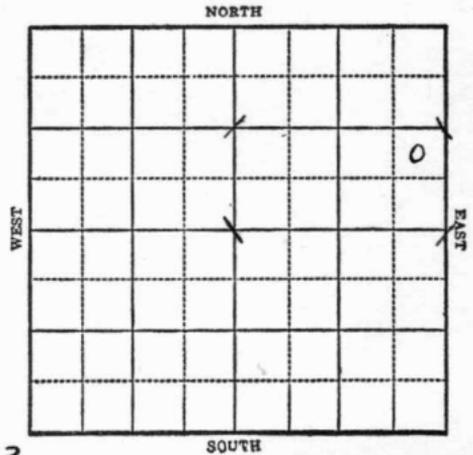

*Elev. 1903*

1943

R E P O R T

- |      |  |
|------|--|
| 6/16 | Cellar   |
| 6/23 | Cable rig  |
| 6/30 | Drlg. 465'   |
| 7/7  | 13" @ 471'<br>Anhy 756'<br>10" @ 760'<br>Drlg. 1575'         |
| 7/15 | Drlg. 2210'  |
| 7/21 | 2522' UR 8"  |
| 7/28 | 8" @ 2505<br>Tepeka 2640<br>6" @ 2865'<br>Drlg. 2886'        |
| 8/4  | 6" @ 3085'<br>T.D. 3205' SD                                  |
| 8/11 | Lans 3090<br>Congl 3317<br>3329 fsg.                         |
| 8/18 | Sand 3366-70 SO<br>Granite to Wash 3428<br>T.D. 3432<br>HFW. |

OVER

1943

8/25

Granite Wash 3428'

HFW

T.D. 3438'

**ABANDONED**

Barton

Map No. **KANSAS** Sec. 36 Twp. 16 R. 12W

Well No. 1 Seyfert

Black-Marshall Company

FIRST REPORT Contractor

NE SE NE


SECTION PLAT

\_\_\_\_\_ Ft. from N. Line

990 Ft. from S. Line

330 Ft. from E. Line

\_\_\_\_\_ Ft. from W. Line

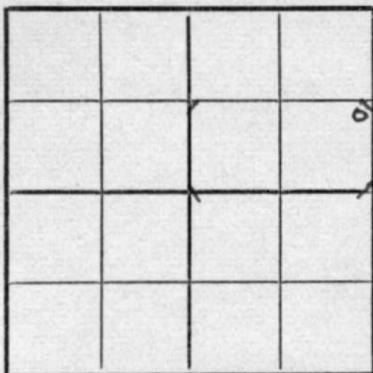

BEAVER POOL

Location \_\_\_\_\_

Rig up \_\_\_\_\_

Drilling and Remarks:

Cellar

RECORD

Cased \_\_\_\_\_ in., \_\_\_\_\_ ft.

Sand \_\_\_\_\_

Gas \_\_\_\_\_

Oil \_\_\_\_\_

Total Depth \_\_\_\_\_

PRODUCTION

1st 24 hrs. Nat. \_\_\_\_\_

1st 24 hrs. after shot \_\_\_\_\_

Gas \_\_\_\_\_ Cu. Ft.

Dry Hole \_\_\_\_\_

Abandoned \_\_\_\_\_

Date

JUN 16 1943 19

S. J. LEWIS Scout

**KANSAS**

Map No. 55 Sec. **36** Twp. **16** R. **12W**

Well No. **1 Seyfert**

**Black-Marshall** Company

**ABANDONED** Contractor

**NE SE NE**

**SECTION PLAT**

\_\_\_\_\_ Ft. from N. Line

**990** Ft. from S. Line

**330** Ft. from E. Line

\_\_\_\_\_ Ft. from W. Line

			o

**Beaver Pool**

Location \_\_\_\_\_

Rig up \_\_\_\_\_

Drilling and Remarks:

*Granite Wash*  
*3428.*

*NFW.*

**RECORD**

Cased \_\_\_\_\_ in., \_\_\_\_\_ ft.

Sand \_\_\_\_\_

Gas \_\_\_\_\_

Oil \_\_\_\_\_

Total Depth *3435*

**PRODUCTION**

1st 24 hrs. Nat. *111*

1st 24 hrs. after shot \_\_\_\_\_

Gas \_\_\_\_\_ Cu. Ft.

Dry Hole \_\_\_\_\_

Abandoned \_\_\_\_\_

Date

**AUG 25 1943** 19 \_\_\_\_\_

**S. J. LEWIS** Scout