


Section 4 Township 15 Range 13W

Well No. #1-Hefferman Logg

Company Fred J. Haynes

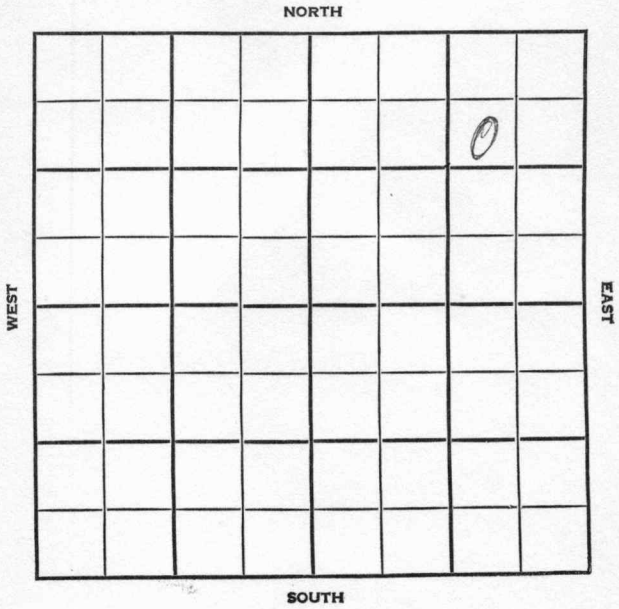

County Russell Elev. \_\_\_\_\_  
 Sec. 4 Twp. 15 Rge. 13W  
 Company Fred J. Haynes  
 FarmName Hefferman No. 1

TOPS	DEPTH	LOG	DATUM
Anh.			
Tp.			
H.			
Tr.			
Dg.			
Bl.			
L.			
K.C.			
B.K.C.			
Ce.			
C.			
M.			
M.			
K.			
Mz.			
Mq.			
V.			
S.			
S.			
A.			
R.			
Pe.			
G.			
T.D.			

Loc. in Sec. \_\_\_\_\_

SW NE NE

Geol. \_\_\_\_\_

Contr. \_\_\_\_\_

Co. tools

Pool \_\_\_\_\_

Trapp

	NOV 21 1950	
FIRST	REPORT	

Date Comm. \_\_\_\_\_

Location \_\_\_\_\_

~~2~~

Co.

Lsc.

No.

Sec.

T.

R.

