

KANSAS Russell


FORM 51 5M 4-41 PETROL

O.W.W.O.

Section 4 Township 15 Range 13-W

Well No. #2 Letsch "B"

Company Stanolind

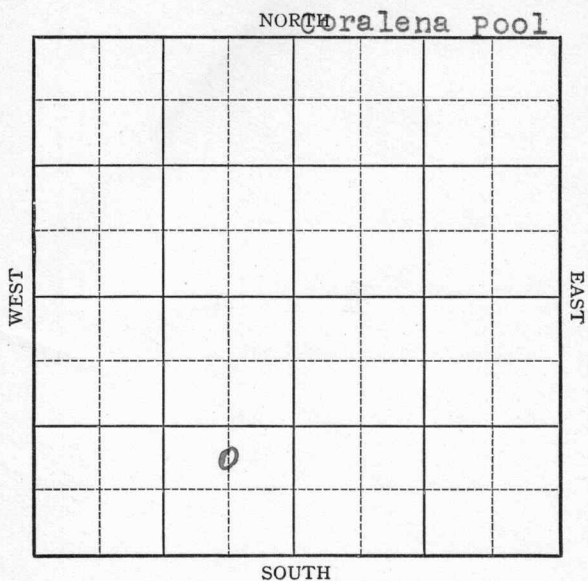

O.W.W.O.

Sec. 4 Twp. 15 R. 13-W

Well No. #2 Letsch "B" Farm

Stanolind Company

(Coralena)

         Ft. from N. Line


990 Ft. from S. Line

660 Ft. from E. Line

         Ft. from W. Line

C N L S E S W

Elev. 1791

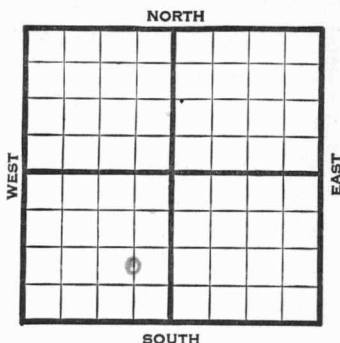

1941	REPORT
10/1	Location
10/9	"
10/16	"
10/23	Derrick.
10/30	8" - 544' Anhy 756' Drlg. 1273'
11/6	Topeka 2663' Lans. 2952' Drlg. 2977' S.S.O.
11/13	Pay 2992-3007' T.D. 3008' 5" - 2981' Swab 5 gals. oil per hour.
11/20	5000 acid.
11/25	Lans. 2952' 5" - 2981' T.D. 3008' 5000 acid. Depthograph potential 3127 bbls. Maximum 3000 bbls. 38.2 Gravity

COMPLETED

OVER

O.W.W.O.

1953  
11/11

Oil Well  
TD 3256'  
Lans 2952'  
5" @ 2981'  
OTD 3008'  
DD  
Arb. 3252'  
TD 3256'  
4" liner @ 3246'  $3\frac{1}{2}$  boph  
C omp. 25 bopd

FIRST REPORT  
✓  
COMPLETED





O.W.W.O.

County **Russell** State **Kansas**

Sec. **4** (Blk. **15** (Sur. Rge.) **13W**) (Twp.) Map No.

Operator **Stanolind**

Well No. **2** Farm **J. Letsch "B"**

Elev. **1791** Location **C N L S E SW**


990 Ft. From **S** Line **SW**

660 Ft. From **E** Line **Quarter**

1st. Report **NOV 11 1953**

Completion **NOV 11 1953**

Remarks **O.W.W.O.**

Spudding Date **O.W.W.O.**

Drlg. Data **Oilwell TD 3256**

**Lans. 2952 5" @ 2981 OTD 3008 DD**

**Arb. 3252 TD 3256 4" liner @ 3246**

**3½ boph Comp. 25 bopd**

J. G. McGEHEE