

# KANSAS


FORM 51 5M 4-41 PETROL

Russell

Section 4 Township 15 Range 13-W

Well No. 1 Letsch "B"

Company Stanolind

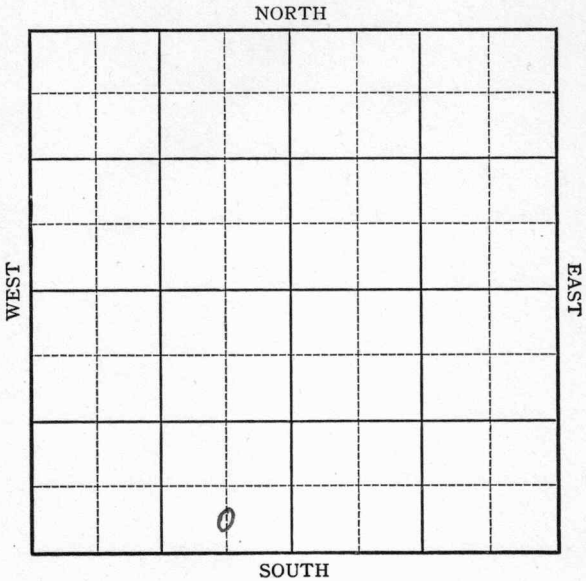



Map No. 73 Sec. 4 Twp. 15 R. 13W

Well No. 1 Letsch "B"

Stanolind Company

FIRST REPORT Contractor


C S L SE SW SECTION PLAT

         Ft. from N. Line

330 Ft. from S. Line

660 Ft. from E. Line

         Ft. from W. Line

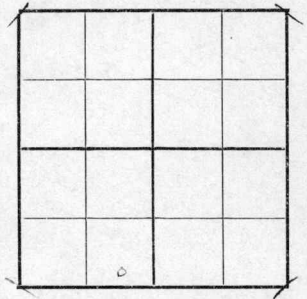

CORALENA POOL

Location                                 

Rig up                                 

Drilling and Remarks:

Derrick

RECORD

Cased                  in.,                  ft.

Sand                                 

Gas                                 

Oil                                 

Total Depth                                 

PRODUCTION

1st 24 hrs. Nat.                                 

1st 24 hrs. after shot                                 

Gas                                  Cu. Ft.

Dry Hole                                 

Abandoned                                 

Date JUL 9 1941

19

S. J. LEWIS Scout

Map No. \_\_\_\_\_ Sec. 4 Twp. 15 R. 13W

Well No. 1 Letsoh "B"

Stanolind Company

COMPLETED Contractor

SECTION PLAT

C S L SE SW

\_\_\_\_\_ Ft. from N. Line

330 Ft. from S. Line

660 Ft. from E. Line

\_\_\_\_\_ Ft. from W. Line

CORALENA POOL


Location \_\_\_\_\_

Rig up \_\_\_\_\_

Drilling and Remarks:

*Li ans 2940*  
*7" C 3016*  
*173 sh to 2965 ft*  
*6000 acid*  
*Dept P 15503*  
*Max 3000*

RECORD

Cased \_\_\_\_\_ in., \_\_\_\_\_ ft.

Sand \_\_\_\_\_

Gas \_\_\_\_\_

Oil \_\_\_\_\_

Total Depth 3020

PRODUCTION

1st 24 hrs. Nat. \_\_\_\_\_

1st 24 hrs. after shot \_\_\_\_\_

Gas \_\_\_\_\_ Cu. Ft.

Dry Hole \_\_\_\_\_

Abandoned \_\_\_\_\_

Date 38<sup>2</sup> 4V

SEP 17 1941 19

S. J. LEWIS Scout

1941

9/17

Lans. 2940'

7" - 3016'

T.D. 3020'

173 shots 2965-95'

6000 acid.

Depthograph potential 15,553 bbls.

Maximum 3000 bbls.

38.2 Gravity

**COMPLETED**