

KANSAS


Russell

FORM 51 5M 4-41 PETROL

Section 4 Township 15 Range 13-W

Well No. #3 Letsch "A"

Company Stanolind

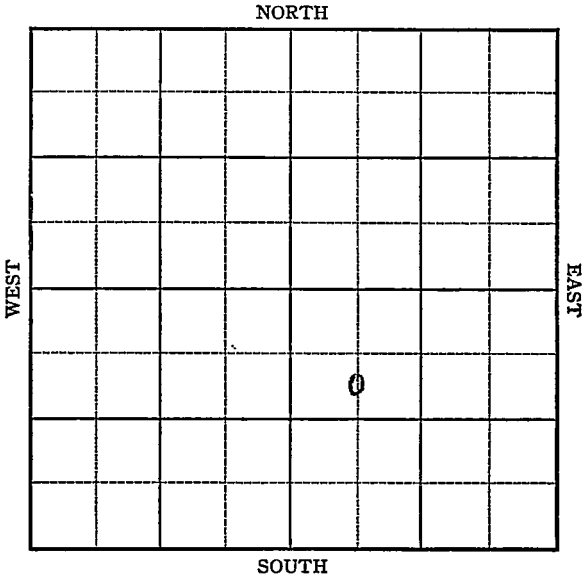

Sec. 4 Twp. 15 R. 13 - W

Well No. #3 Letsch "A" Farm

Stanolind Company

(Trapp)


990 Ft. from N. Line

_____ Ft. from S. Line

_____ Ft. from E. Line

660 Ft. from W. Line

Elev. 1753

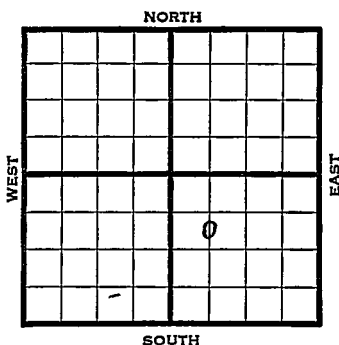

1941	REPORT
10/29	Cellar.
11/6	Derrick.
11/13	Spud.
11/20	15" - 325' 13" - 553' WOC.
11/26	Anhy 713' 10" - 719'
	Drlg. 1335'
12/4	Drlg. 2135'
12/11	SSO 2307-15
	TD 2432 WR 8"
12/18	8" @ 2427
	Topeka 2655
	Dodge 2892
	SSO Lans. 2940
	Drlg. 2941
12/24	7" - 3016 ' T.D. 3044' Water.
12/31	P.B. to 2914' 7" - 2914'
	12 shots 2886-92'
1942	
1/8	P.B. to 2910' Swab 2½ oil & 2½ water. Shut down.
1/15	" " "

OVER

Russell

KANSAS

Map No. 73 Sec. 4 Twp. 15 R. 13WWell No. 3 Letsch "A"Stanolind

Company

COMPLETED

Contractor

C SL NW SE

990 Ft. from N. Line

_____ Ft. from S. Line

_____ Ft. from E. Line

660 Ft. from W. Line

SECTION PLAT

		o	

TRAPP POOL

RECORD

Location _____

Cased _____ in., _____ ft.

Rig up _____

Sand _____

Drilling and Remarks:

Gas _____

Oil _____

Total Depth 3844

PRODUCTION

1st 24 hrs. Nat. _____

1st 24 hrs. after shot _____

Gas _____ Cu. Ft.

Dry Hole _____

Abandoned _____

Dodge 2887
2 C 2914
PB 2910
36 shot to 2886-92
2500 acid
Pump 418 oil
+ 15 water

350 hr

Date

JAN 21 1942 19

S. I. LEWIS Scout

1942
1/21

Dodge 2887'
7" - 2914'
T.D. 3044'
P.B. to 2910'
36 shots 2886-92'
2500 acid.
Potential 418 oil & 15 water on
pump.
38. Gravity

COMPLETED