Form 51—5M—11-38—Palace


Barton

KANSAS

Section 2 Township 16 Range 13-W

Well No. 1 Rud Est.

Company Broswood Oil & Wakefield

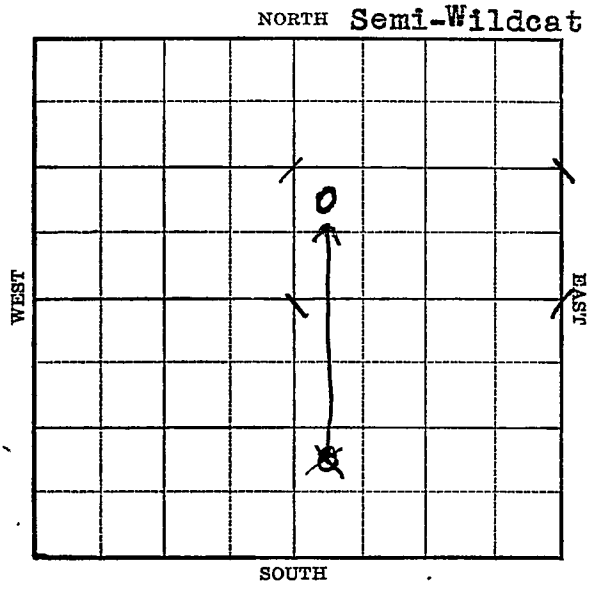

FORM 252-A 5M 4-39 **KANSAS** Barton

Sec. 2 Twp. 16 R. 13-W

Well No. #1 Rud Est. Farm

Broswood Oil & Wakefield Company


(Semi-Wildcat)

____ Ft. from N. Line

990 Ft. from S. Line

____ Ft. from E. Line

330 Ft. from W. Line

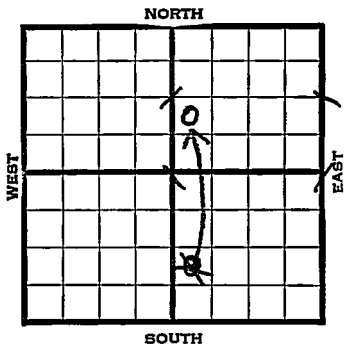

Elev. 1887

1939	REPORT
5/24	Cable Rig.
6/1	Spud 180'
6/8	12" @ 425, Anhy 855'
	10" @ 855 Drlg. 900'
6/16	Drlg. 2020'
6/23	8" - 2162' 7" - 2547'
	Drlg. 2625'
6/29	Topeka 2780' 7" - 2747'
	Dodge 3032' Lans. 3103'
	T.D. 3105' U.R. 5".
7/6	S. O. 3122' S.O. 3154-59'
	Cong. 3347' Drlg. 3342'
7/12	Arb. 3370'
	T.D. 3388' H.F.W.
	ABANDONED

Form 26—1M Bks.—2-29

Barton KANSAS

Map No. 73 Sec. 2 Twp. 16 R. 13W

Well No. 1 Rud Est.

Broswood Oil & Wakefield Company

Contractor

FIRST REPORT

NW SW SE

_____ Ft. from N. Line


990 Ft. from S. Line

_____ Ft. from E. Line

330 Ft. from W. Line

SEMI-WILDCAT

SECTION PLAT

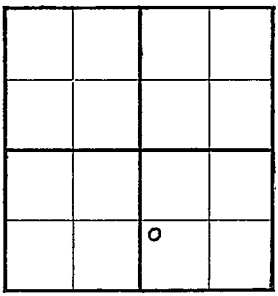

Location _____

Rig up _____

Drilling and Remarks:

Cable Rig

RECORD

Cased _____ in., _____ ft.

Sand _____

Gas _____

Oil _____

Total Depth _____

PRODUCTION

1st 24 hrs. Nat. _____

1st 24 hrs. after shot _____

Gas _____ Cu. Ft.

Dry Hole _____

Abandoned _____

Date

MAY 24 1939 19____

S. J. LEWIS Scout.

Form 26—1M Bks.—2-29 Barton KANSAS

Map No. _____ Sec. 2 Twp. 16 R. 13W

Well No. 1 Rud Est.

Broswood Oil & Wakefield Company

_____ Contractor

CORRECTION

NW SW NE

_____ Ft. from N. Line


990 Ft. from S. Line

_____ Ft. from E. Line

330 Ft. from W. Line

SEMI-WILDCAT

SECTION PLAT

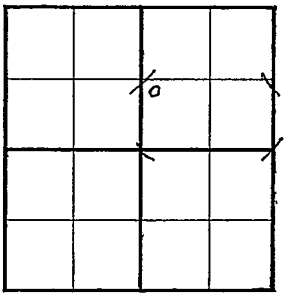

Location _____

Rig up _____

Drilling and Remarks:

Reported
NW SW SE

RECORD

Cased _____ in., _____ ft.

Sand _____

Gas _____

Oil _____

Total Depth _____

PRODUCTION

1st 24 hrs. Nat. _____

1st 24 hrs. after shot _____

Gas _____ Cu. Ft.

Dry Hole _____

Abandoned _____

Date

MAY 31 1939 19____ S. J. LEWIS Scout

Form 26—1M Bks.—2-29 Barton KANSAS

Map No. ____ Sec. 2 Twp. 16 R. 13W

Well No. 1 Rud Est.

Broswood Oil & Wakefield Company

____ Contractor

ABANDONED
NW SW NE

____ Ft. from N. Line


990 Ft. from S. Line

____ Ft. from E. Line

330 Ft. from W. Line

SEMI-WILDCAT

SECTION PLAT

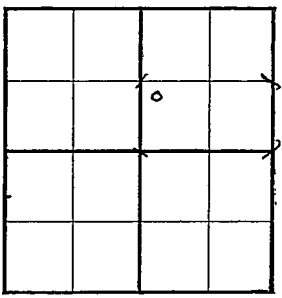

Location ____

Rig up ____

Drilling and Remarks:

Ar 3370

HFW.

RECORD

Cased ____ in., ____ ft.

Sand ____

Gas ____

Oil ____

Total Depth 3388

PRODUCTION

1st 24 hrs. Nat. ____

1st 24 hrs. after shot ____

Gas ____ Cu. Ft.

Dry Hole ____

Abandoned ____

Date

JUL 12 1939 19____

S. J. LEWIS Scout