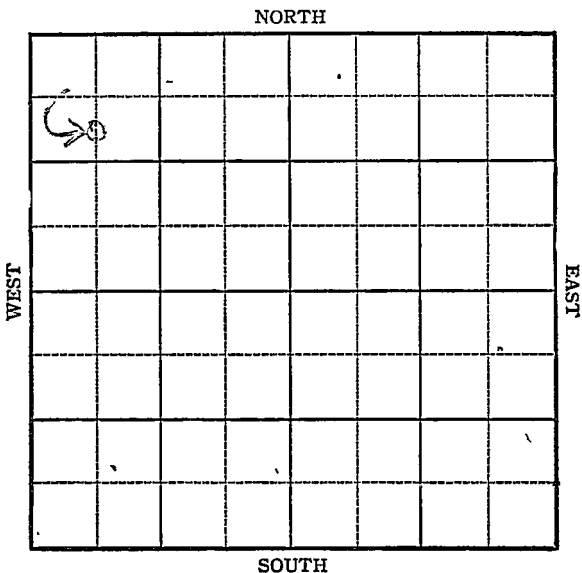


KANSAS

Barton County

Section 3 Township 16 Range 13WWell No. #1 EichmanCompany Texas

KANSAS Barton County

Sec. 3 Twp. 16 R. 13W

Well No. #1 Eichman Farm

Texas

Company

Kraft-Prusa

660 Ft. from N. Line

Ft. from S. Line

Ft. from E. Line


330 Ft. from W. Line

CSL

GWE NW NW

Elev. 1884

SOUTH

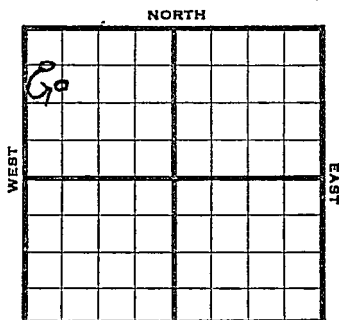

1944

R E P O R T

10/4	Location
10/11	"
10/18	"
10/25	RUR
11/2	Drig. 325
11/8	Drig. 2105
11/16	Arb 3361
	TD 3408
11/22	Lans 3093'
	BKC 3333'
	Arb. 3376
	TD 3443


ABANDONED

KANSAS

Pool Name Kraft-PruseMap No. 73 Sec. 3 Twp. 16 R. 13WWell No. 1 EichmanTexas CompanyFIRST REPORT Contractor

C W L NW NW

SECTION PLAT

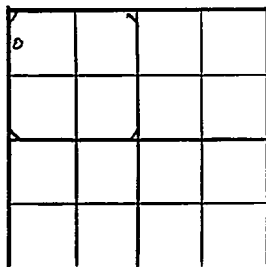660 Ft. from N. Line Ft. from S. Line Ft. from E. Line330 Ft. from W. LineBarton CountyLocation XRig up

Drilling and Remarks:

RECORD

Cased in. ft.Sand Gas Oil Total Depth

PRODUCTION

1st 24 hrs. Nat. 1st 24 hrs. after shot Gas Cu. Ft.Dry Hole Abandoned

Date

OCT 4 1944 19 S. J. LEWIS Scout

Pool Name Kraft-PrusaMap No. 73 Sec. 3 Twp. 16 R. 13WWell No. 1 EichmanTexas


Company

CORRECTION

Contractor

C S L NW NW

SECTION PLAT

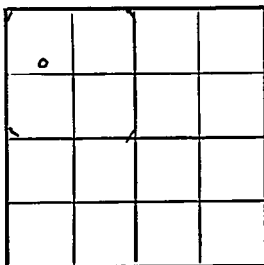990 Ft. from N. Line Ft. from S. Line Ft. from E. Line660 Ft. from W. LineBarton

RECORD

Location Cased in. ft.Rig up Sand

Drilling and Remarks:

Gas ReportedOil C W L NW NWTotal Depth

PRODUCTION

1st 24 hrs. Nat. 1st 24 hrs. after shot Gas Cu. Ft.Dry Hole Abandoned

Date

OCT 11 1944 19S. J. LEWIS

Scout

Pool Name Kraft-PrusaMap No. 73 Sec. 3 Twp. 16 R. 13WWell No. 1 EichmanTexas CompanyABANDONED Contractor

C S L NW NW

SECTION PLAT

990 Ft. from N. Line Ft. from S. Line Ft. from E. Line660 Ft. from W. LineBartonLocation Rig up

Drilling and Remarks:

Loss 3023BTC 3333Ar 3376

RECORD

Cased in., ft.Sand Gas Oil Total Depth 3443

PRODUCTION

1st 24 hrs. Nat. 1st 24 hrs. after shot Gas Cu. Ft.Dry Hole Abandoned

Date

NOV 22 1944 19S. J. LEWIS Scout