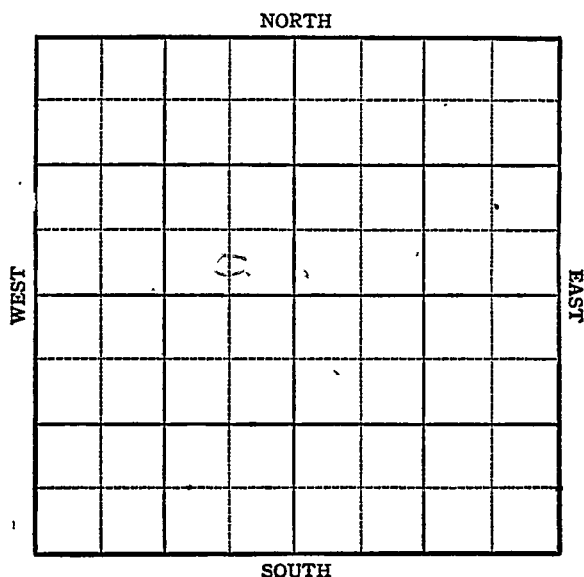


KANSAS

Russell County

Section 4 Township 15 Range 13WWell No. #1 John HeffermanCompany Stanolind

KANSAS

Russell County

Sec. 4 Twp. 15 R. 13W


Well No. #1 John Hefferman Farm

Stanolind

Company

Hall-Gurney

NORTH

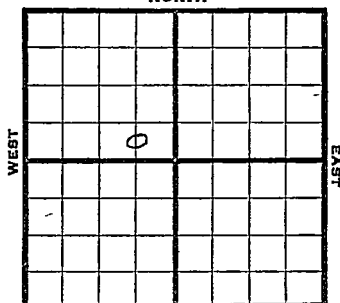

Ft. from N. Line

330

Ft. from S. Line

660

Ft. from E. Line

Ft. from W. Line

CSL SE NW Lev. 1791 SOUTH

1944

R E P O R T

11/15 Derrick

11/24 Arby 760 8" @ 784 Drlg. 1204'

11/29 Topeka 2664 Hebner 2895 Lans 2062
TD 2999

12/6 Arb. 3244

TD 3266

Water

12/14 TD 3310' in arb.
5" @ 3274' RUST

12/21 PB 3227

6 shots 2911-2919

12/29 Swb 53 oil & 6 water in 14 hrs.
off bottom

1945

1/3 36 Shots 2980-88 500 acid & gas
1500 acid swb 3/4 oil in 4 hrs
24 shots to 2992-98 2500 acid
swb & oil PH 16 hrs - 36 shots
3006-16 - 2500 acid CO

1/10 Swab 268 oil in 17 hrs

1/17 " " " " " "

1/26 " " " " "

1/31 " " " " "

2/7 " " " " "


2/14 " " " " "

OVER

Pool Name Hall - HurneyMap No. 73 Sec. 4 Twp. 15 R. 13WWell No. 1 John HeffermanStanolind CompanyFIRST REPORT Contractor

C S L SE NW

SECTION PLAT

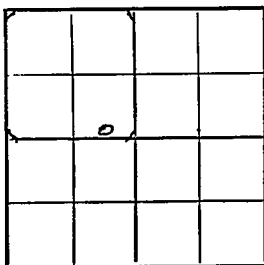 Ft. from N. Line330 Ft. from S. Line660 Ft. from E. Line Ft. from W. LineRussellLocation Rig up

Drilling and Remarks:

derrick

RECORD

Cased in., ft.Sand Gas Oil Total Depth

PRODUCTION

1st 24 hrs. Nat. 1st 24 hrs. after shot Gas Cu. Ft.Dry Hole Abandoned

Date

NOV 15 1944

19

S. J. LEWIS Scout

Pool Name Hall-GurneyMap No. 78 Sec. 4 Twp. 15 R. 13WWell No. 1 John HeffermanStanolind


Company

COMPLETED

Contractor

C S L SE NW

SECTION PLAT

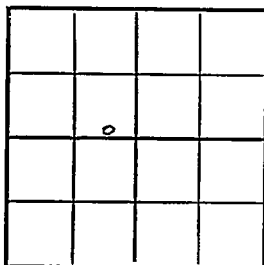

Ft. from N. Line

330 Ft. from S. Line660 Ft. from E. Line

Ft. from W. Line

Russell

Location

Rig up

Drilling and Remarks:

Ward 2962Cr 832445" @ 3274Prof. Loss.4000 acidPump 247 oil + 2478Water P. X40 E Gr

Date

RECORD

Cased _____ in., _____ ft.

Sand _____

Gas _____

Oil _____

Total Depth 3210

PRODUCTION

1st 24 hrs. Nat. _____

1st 24 hrs. after shot _____

Gas _____ Cu. Ft.

Dry Hole _____

Abandoned _____

FEB 21 1945 19

S. J. LEWIS

Scout

1945

2/21 Lans 2962
 Arb 3244
 5" @ 3274
 Perf. Lans 4000 acid
 TD 3310
 Pump 247 oil plus 24% water.
 Pot.
 Grav. 40.8

COMPLETED