


Section 4 Township 16-S Range 13-W

Well No. #2 Fouts

Company Texas

NORTH Trapp Pool

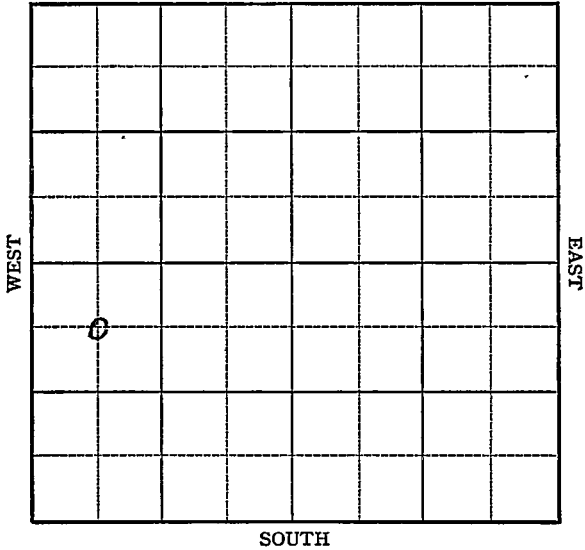

Sec. 4 Twp. 16-S R. 13-W

Well No. #2 Fouts Farm

Texas Company

(Trapp)


660 Ft. from N. Line

_____ Ft. from S. Line

_____ Ft. from E. Line

660 Ft. from W. Line

Elev 1924

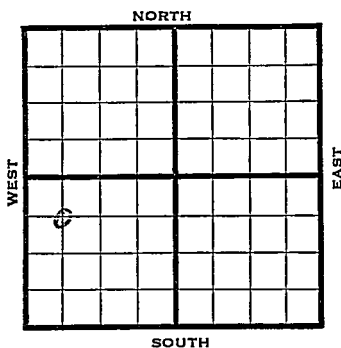

1942 REPORT

7/1	Rotary.
7/8	Drlg. 370'
7/15	10" - 370' Anhy. 895' Drlg: 2566'
7/22	Lans. 3142', Arb. 3382 $\frac{1}{2}$ ' Coring 3392'
7/29	Arb. 3382 $\frac{1}{2}$ ' No shows T.D. 3398'

ABANDONED

Map No. 73 Sec. 4 Twp. 16S R. 13WWell No. 2 FoutsTexas

Company

FIRST REPORT

Contractor

C NW S N

SECTION PLAT

660 Ft. from N. Line

_____ Ft. from S. Line

_____ Ft. from E. Line

660 Ft. from W. Line

Trapp Pool

o			

Location _____

Rig up _____

Drilling and Remarks:

Rotary

RECORD

Cased _____ in., _____ ft.

Sand _____

Gas _____

Oil _____

Total Depth _____

PRODUCTION

1st 24 hrs. Nat. _____

1st 24 hrs. after shot _____

Gas _____ Cu. Ft.

Dry Hole _____

Abandoned _____

Date

JUL 1 1942 19S. J. LEWIS

Scout

Barton KANSASMap No. 73 Sec. 4 Twp. 16 R. 13WWell No. 2 FoutsTexas

Company

ABANDONED

Contractor

SECTION PLAT

C NW SW

660 Ft. from N. Line

_____ Ft. from S. Line

_____ Ft. from E. Line

660 Ft. from W. Line

o			

TRAPP POOL

Location _____

Rig up _____

Drilling and Remarks:

*Cr & 338 1/2**No show*

RECORD

Cased _____ in., _____ ft.

Sand _____

Gas _____

Oil _____

Total Depth 338

PRODUCTION

1st 24 hrs. Nat. _____

1st 24 hrs. after shot _____

Gas _____ Cu. Ft.

Dry Hole _____

Abandoned _____

Date

JUL 29 1942 19S. J. LEWIS Scout