


Cowley

KANSAS

Section 2 Township 30 Range 4-E

Well No. #1 Blood

Company E. B. Shawver

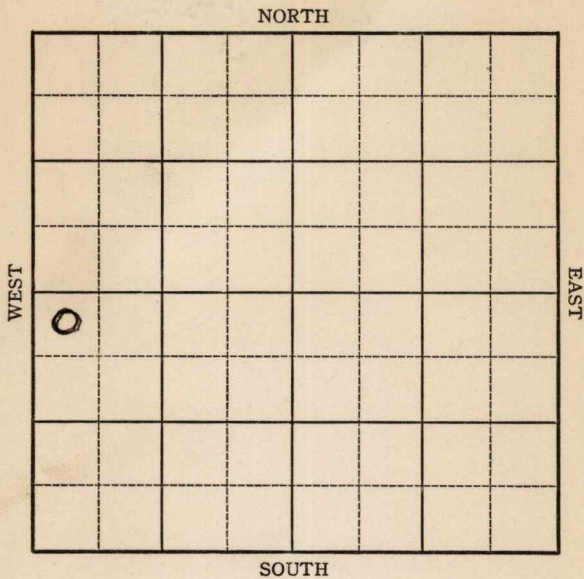

Sec. 2 Twp. 30 R. 4-E

Well No. #1 Blood Farm  
E. B. Shawver Company


330 Ft. from N. Line

\_\_\_\_\_ Ft. from S. Line

\_\_\_\_\_ Ft. from E. Line

330 Ft. from W. Line

Elev. 1239

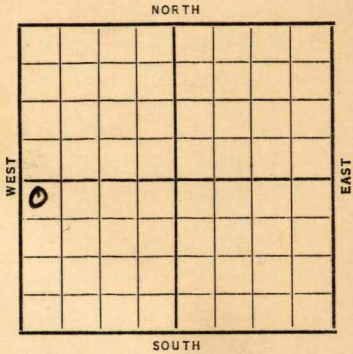

Date	REPORT
1937	
11/17	Location
11/26	"
12/3	R. U. Machine.
12/10	15" @ 40'. Drlg. 650'.
12/17	12" @ 830'. SD repairs.
12/24	Drlg. 1625'.
12/31	10" @ 1625'. Drlg. 1995'.
1938	
1/7	Drlg. 2180'.
1/14	Stalnaker 1880-2014'.
	H.F.W. 8" @ 2025'.
	K.C. 2250'. 2 B.W. 2365'.
	6" @ 2550'. Drlg. 2690'.
1/20	7" - 2771' C.O.
1/28	5" liner - 2808'
	Bart 2808? T.D. 2817' in
	shale. S.S.O.
2/4	Will Shoot
2/11	P.B. 2815'.
	42 shots 2808-15'. 1100' oil over-nite. Shot 20 qts. C.O.

OVER

1938

2/18 P.B. 2815'.

2/23 7" @ 2771'.

5" liner 2808'.

Bart. 2808'?

T.D. 2817'.

P.B. 2815'.

Perforated 42 shots 2808-15'.

20 qts.

Potential 15 bbls.

**COMPLETED**

Map No. // Sec. 2 Twp. 30 R. 4E

Well No. 1 Blood

E. B. Shawver Company

Contractor

FIRST REPORT

NW SW

330 Ft. from N. Line

Ft. from S. Line

Ft. from E. Line

330 Ft. from W. Line

SECTION PLAT

0			

Location X

Rig up

Drilling and Remarks:

RECORD

Cased in., ft.

Sand

Gas

Oil

Total Depth

PRODUCTION

1st 24 hrs. Nat.

1st 24 hrs. after shot

Gas Cu. Ft.

Dry Hole

Abandoned

Date

NOV 17 1937 19

H. D. Hatfield Scout

Map No. // Sec. 2 Twp. 30 R. 4E

Well No. 1 Blood

E. B. Shawver

Company

Contractor

COMPLETED

NW SW

330 Ft. from N. Line

Ft. from S. Line

Ft. from E. Line

330 Ft. from W. Line

SECTION PLAT

0			

Location

Rig up

Drilling and Remarks:

P.B. 2815

Perforated 42 shots

2808-15

20 gts

POT-15

7" - 2771 RECORD

Cased 5" Liner 2808 ft.

Sand Bart 2808?

Gas

Oil

Total Depth 2817

PRODUCTION

1st 24 hrs. Nat.

1st 24 hrs. after shot

Gas Cu. Ft.

Dry Hole

Abandoned

Date

FEB 23 1938

19

H. D. Hatfield Scout