

KANSAS


FORM 51 5M 1-42 PETROL

Russell

Section 3 Township 15 Range 14-W

Well No. #1 Krug

Company Pryor & Lockhart

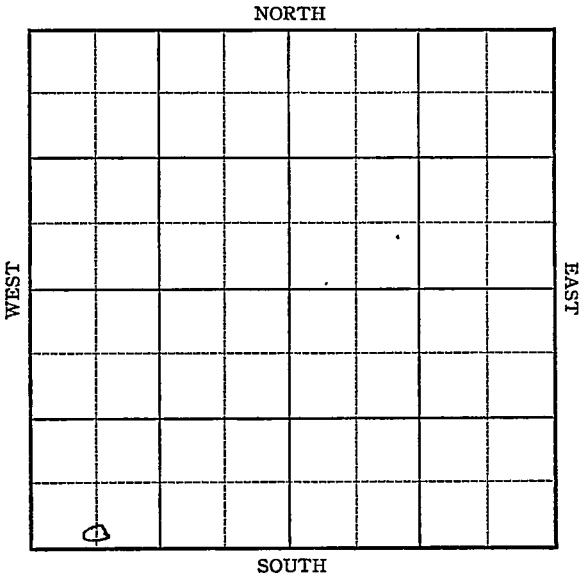

Sec. 3 Twp. 15 R. 14-W

Well No. #1 Krug Farm

Pryor & Lockhart Company

Wildcat


 Ft. from N. Line

330 Ft. from S. Line

 Ft. from E. Line

660 Ft. from W. Line

Elev. 1763 (Est)

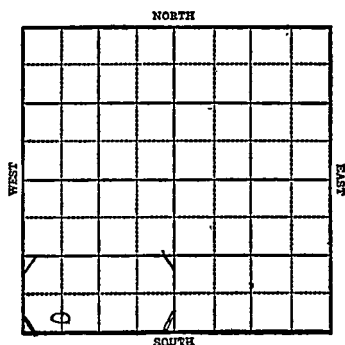

1943	R E P O R T	
4/7	Location	Argo Farmout
4/14	"	
4/21	"	
4/28	15" @ 55' 13" @ 379' Drlg. 700'	
5/5	Anhy 764 Drlg. 1840'	
5/12	Drlg. 2405'	
5/19	8" @ 2425 2990 fsg.	
5/26	Lans 3018 7" @ 2993 SO 3018 Drlg. 3023	
6/2	Arb. 3271 I.D. 3281'	
	HFW	
	ABANDONED	

Russell

KANSAS

Map No. 73 Sec. 3 Twp. 15 R. 14WWell No. 1 KrugPryor & Lockhart


Company

FIRST REPORT

Contractor

C S L S W S W

SECTION PLAT

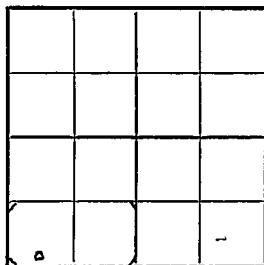 Ft. from N. Line330 Ft. from S. Line Ft. from E. Line660 Ft. from W. Line

WILDCAT

Location XXXRig up

Drilling and Remarks:

Argo Farmout

RECORD

Cased in., ft.Sand Gas Oil Total Depth

PRÓDUCTION

1st 24 hrs. Nat. 1st 24 hrs. after shot Gas Cu. Ft.Dry Hole Abandoned

Date

APR 7 1943 19 S. J. LEWIS Scout

KANSAS

Russell

Map No. 73 Sec. 3 Twp. 15 R. 14WWell No. 1 Krug

Pryor & Lockhart


Company

ABANDONED

Contractor

C SL SW SW

SECTION PLAT

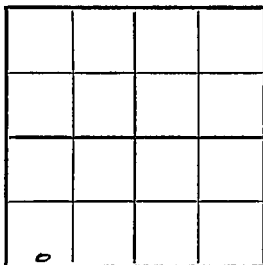 Ft. from N. Line330 Ft. from S. Line Ft. from E. Line660 Ft. from W. Line

WIID CAT

Location Rig up

Drilling and Remarks:

*Cor 83271**NFW*

RECORD

Cased in., ft.Sand Gas Oil Total Depth 83271

PRODUCTION

1st 24 hrs. Nat. 1st 24 hrs. after shot Gas Cu. Ft.Dry Hole Abandoned

Date

JUN 2 1943 19S. J. LEWIS

Scout