


Section 3 Township 15 Range 14-W

Well No. #3 Krug

Company N C R A

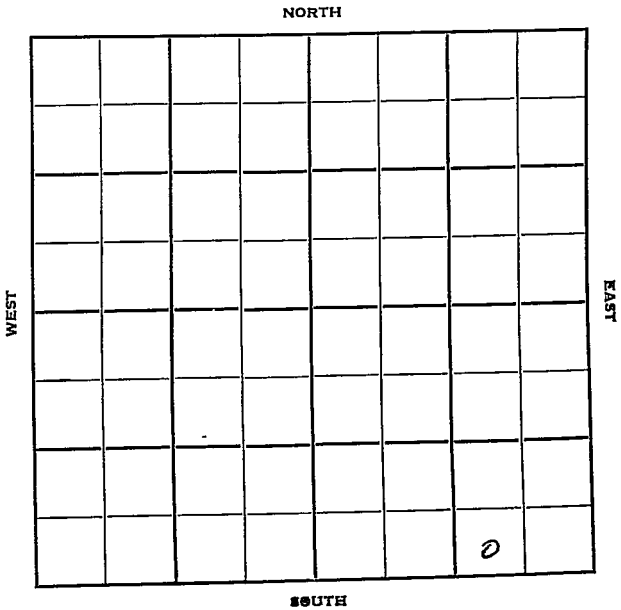

KANSAS

Russell

Sec. 3 Twp. 15 R. 14-W

Well No. #3 Krug Farm

N C R A

N C R A Contractor Company

Trapp Pool

O.W.W.O.


Ft. from N. Line

330 Ft. from S. Line

990 Ft. from E. Line

Ft. from W. Line

SW SE SE

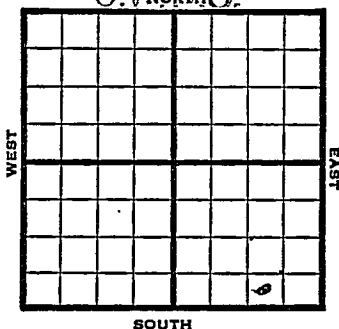

1950

Elev 1720' REPORT

2/22

RUR

4/26

TD 2529'

12 1/2" @ 369'

Anhy 730'

10" @ 730'

SSO 2425'

8" @ 2460'

TD 2529'

Swab 190 BOPD

Pump 8 BO / 8 BWPB in Topeka

Comp 150 BOPD

Comp

COMPLETED

O.W.W.O.

1950

6/21

OTD 2529'

150 BOPD & wtr

DD SO 2917-20

Lans. 2955

HEW 3125-30

DD 3150

7" @ 3141

Marm 3205' Arb 3221'

Gongl 3210' SO 3229-35

B/ 1/2 bailer oil 1 hr

B/ 12 BO 24 hrs.

5" @ 3235'

OVER

Kansas

Trapp Pool

Map No. _____ Sec. 3 Twp. 15 R. 14WWell No. 3 Krug

NCRA

Company

Contractor

SW SE SE


E1-1720

SECTION PLAT

_____ Ft. from N. Line

330 Ft. from S. Line990 Ft. from E. Line

_____ Ft. from W. Line

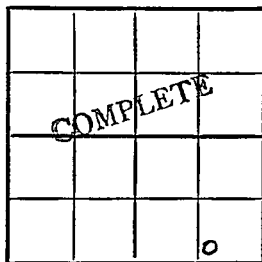

Russell County

Location _____

Rig up _____

Drilling and Remarks:

12 1/2" C 369

any 730

10" C 730

SSO 2425

8" C 2460

T.D. 2529

Swal 190 bop

RECORD

Cased _____ in., _____ ft.

Sand _____

Gas _____

Oil _____

Total Depth 2529

PRODUCTION

1st 24 hrs. Nat. _____

1st 24 hrs. after shot _____

Gas _____ Cu. Ft.

Dry Hole _____

Abandoned _____

Date

APR 26 1950 19

J. E. TYRA


Scout

Pump 8 be + 8 lumph in Dyke
Comp. 150 bpd

1950

MAY 3

Scout Cards	
Land-Small Map	
Land Wall Map	
Tracings	
France Map	
Pierce Map	
Misc.	

 

WELL

Kansas

Map No. _____ Sec. 3 Twp. 15 R. 14Well No. 3 Krug

N C R A

Company

O.W.W.O.

Contractor

SW SE S^{TT}E1. 1720
SECTION PLAT

_____ Ft. from N. Line

330 Ft. from S. Line990 Ft. from E. Line

_____ Ft. from W. Line



Russell County

Location _____

Rig up _____

Drilling and Remarks:

OTD 2529

150 bopd & water

DD SO 2917-20

Lans. 2955

HFW 3125-30

DD 3150

7" C 3141

Farm. 3205

RECORD

Cased _____ in., _____ ft.

Sand _____

Gas _____

Oil _____

Total Depth _____

PRODUCTION

1st 24 hrs. Nat. _____

1st 24 hrs. after shot _____

Gas _____ Cu. Ft.

Dry Hole _____

Abandoned _____

Date

JUN 21 1950 19

J. E. TYRA

Scout

Cong. 3210

Arb. 3221

SO 3229-35

B/ 1/2 bailer oil

B/ 12 bo 24 hr.

5" C 3235

Scout Cards
Land Small Map
Land Walp Map
Tracings
France Map
Pierce Map
Misc

23 1950

Page 2

RECORD

SECTION 14

COMMISSION

WATER

WATER


WATER

WATER

Kansas

Map No. _____ Sec. 3 Twp. 15 R. 14WWell No. 3 Krug_____
NCRA _____ Company_____
Contractor

SW SE SE

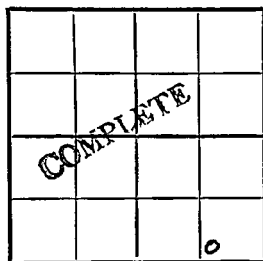E1. 1720
SECTION PLAT_____
Ft. from N. Line330 Ft. from S. Line990 Ft. from E. Line_____
Ft. from W. Line

Russell County

Location _____

Rig up _____

Drilling and Remarks:

OTD 2529

DD to 3236

S/ 20 gal. oph.

Comp. 25 bopd

RECORD

Cased _____ in., _____ ft.

Sand _____

Gas _____

Oil _____

Total Depth _____

PRODUCTION

1st 24 hrs. Nat. _____

1st 24 hrs. after shot _____

Gas _____ Cu. Ft.

Dry Hole _____

Abandoned _____

Date

JUN 28 1950

19

J. E. TVRA Scout

1950

6/28 OTD 2529

DD to 3236

S/20 gal.oph

Comp 25 bopd

Completed

COMPLETED