


Section 2 Township 31 Range 4 E

Well No. # 6 David

Company Colorado Oil & Gas

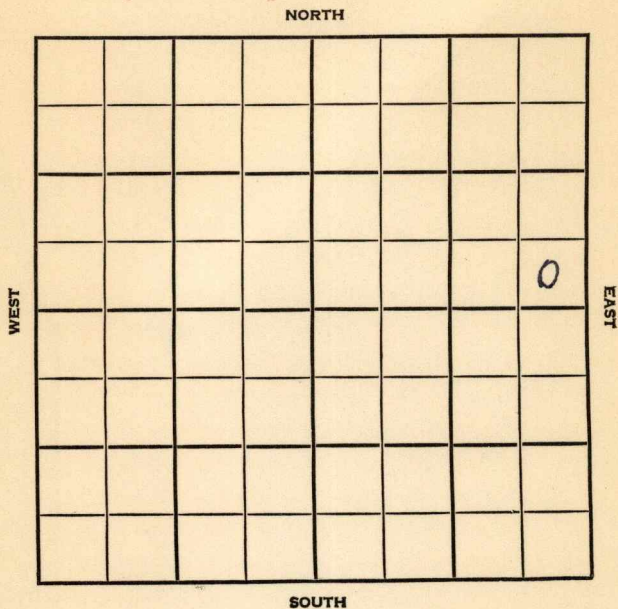

Cowley

KANSAS


SEC.	TWP.	R.
2	31	4E

WELL NO. #6 David FARM

COMPANY Colorado Oil & Gas

CONTRACTOR Capitt Drlg.
David Pool

_____ Ft. from N. Line
330 _____ Ft. from S. Line
330 _____ Ft. from E. Line
_____ Ft. from W. Line

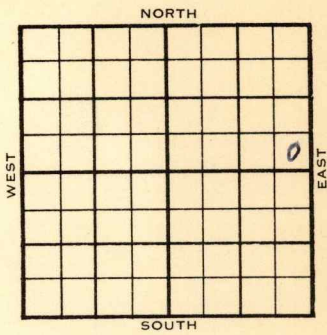

SE SE NE

1955	ELEVATION	REPORT
	1279'	

3/16 Location
4/27 Spud 3-19-55
Oil well TD 2957 8" @ 92
Bart 2939' TD 2947' 5" @ 2941
DD 2955 DD 2957' 18 GW 9 hr.
PB 2953 100 M-A frac P/2 1/4 BO
9-3/4 BW 15 hr.
Comp. 1-3/4 BOPD 13 BW

COMPLETED

County **Cowley** State **Kansas**

Sec. **2** (Blk. Twp.) **31** (Sur. Rge.) **4E** Map No.

Operator **Colorado Oil & Gas**

Well No. **6** Farm **David**

Elev. Location **SE SE NE**

330 Ft. From **S** Line **NE**

330 Ft. From **E** Line Quarter

1st. Report **MAR 16 1955**

Completion

Remarks

Spudding Date

Drlg. Data **David Pool**

Location

FABEN GILSTRAP

