


Section 5 Township 16 Range 13W

Well No. 1 Kosar

Company Delta Prod.

Trapp Pool
NORTH

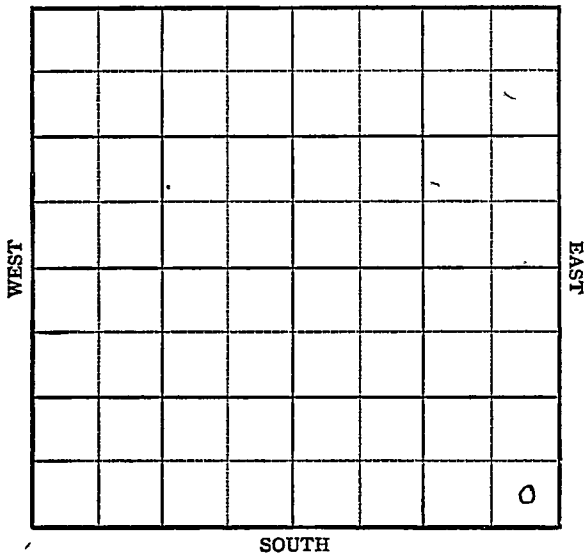

KANSAS


Barton

Sec. 5 Twp. 16 R. 13W

Well No. #1 Kosar Farm
Delta Prod. Company

Trapp Pool

_____ Ft. from N. Line
330' Ft. from S. Line
330' Ft. from E. Line
_____ Ft. from W. Line

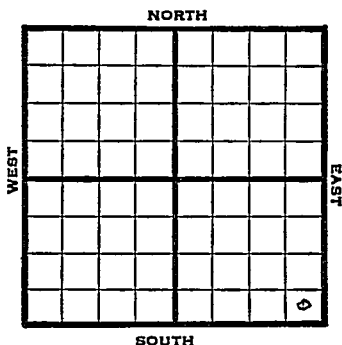

SE/C

1948 Eli 1930' REPORT

8/18 8" @ 230'
Anhy. 883'
Drig. 2170'

8/25 Lansing 3142' -
Arbuckle 3384-86'
TD 3386'
5" @ 3385'

9/1 Swedging 5" dsg.

9/8 TD 3397'
Swb 1/2 bbls oil PH

9/14 500 acid

9/21 "

9/29 "

10/6 "

10/13 "

10/19 "

10/26 "

11/3 "

11/10 TD 3409'
Arb. 3384'
5" @ 3385'
Aband.

ABANDONED

