


Map No. _____ Sec. 3 Twp. 30 R. 4
 Well No. J. & J. Brown Farm _____
 _____ Company

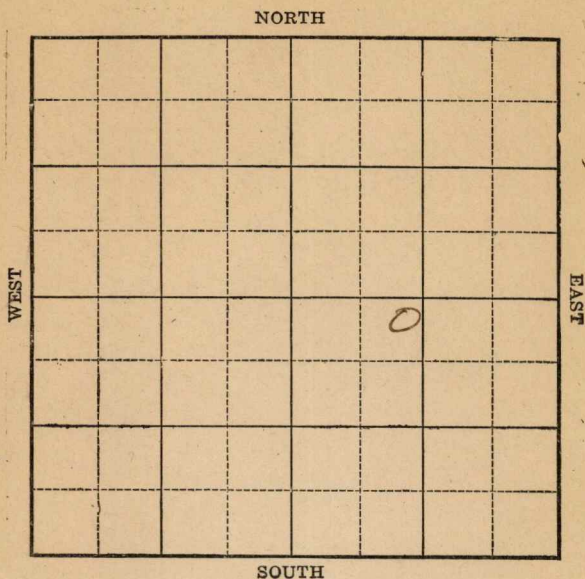

Location _____

Rig up _____

Drilling Remarks:

Drilling Remarks:

RECORD

Cased _____ in. _____ ft.

Sand _____

Gas _____

Oil _____

Total Depth _____

PRODUCTION

1st 24 hrs Nat. _____

1st 24 hrs. after shot _____

Gas _____ cu. ft.

Dry Hole _____

Abandoned _____

Map No. _____ Sec. 3 Twp. 30 R. 4

Well No. 1 Brown Farm


S. & S. _____ **Company**

200 Ft. from N. Line

_____ Ft. from S. Line

_____ Ft. from E. Line

1120 Ft. from W. Line

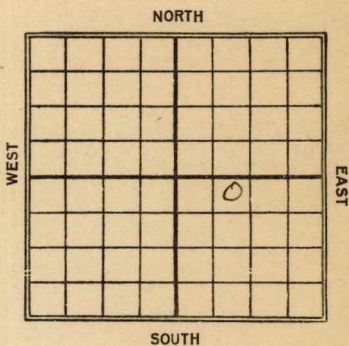

Date _____

REPORT

Date
1923

3/22

6/23

Dec. 10 40'

D. 49. 2880

Map No. **KANSAS** 11 Sec. **3** Twp. **30** R. **4**Well No. **1 Brown**Company **St. Edwards**

Contractor

FIRST REPORT

SECTION PLAT

200

Ft. from N. Line

Ft. from S. Line

Ft. from E. Line

1120

Ft. from W. Line

		6	

Location

Rig up

Drilling and Remarks:

LD. 1040

RECORD

Cased _____ in., _____ ft.

Sand _____

Gas _____

Oil _____

Total Depth _____

PRODUCTION

1st 24 hrs. Nat. _____

1st 24 hrs. after shot _____

Gas _____ Cu. Ft.

Dry Hole _____

Abandoned _____

Date .

MAR 22 1923**M. A. BENEAR****192**

Scout

Map No. **KANSAS** **43** Sec. **30** Twp. **4** R. **4**

Well No. **1 Brown**

H. S. Company

Contractor

ABANDONED SECTION PLAT

200 Ft. from N. Line

Ft. from S. Line

Ft. from E. Line

1120 Ft. from W. Line

		0	

Location

Rig up

Drilling and Remarks:

**sand { 2830
2832**

LOT 9

2880'

RECORD

Cased in., ft.

Sand

Gas

Oil

Total Depth

PRODUCTION

1st 24 hrs. Nat.

1st 24 hrs. after shot

Gas Cu. Ft.

Dry Hole

Abandoned

Date

JUN 23 1923

192

M. A. BENEAR

Scout

Cowley *Cowley*
 K11
 MAP No. **KANSAS** SEC. 3 TWP. 30S R. 4E


WELL No. Brown
Shawver & Sutton COMPANY

CONTRACTOR

SECTION PLAT

ABANDONED

_____ Ft. FROM N. LINE
 _____ Ft. FROM S. LINE
 _____ Ft. FROM E. LINE
 _____ Ft. FROM W. LINE

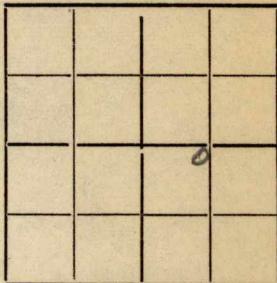

LOCATION _____

RIG UP _____

DRILLING AND REMARKS:

RECORD

CASED _____ IN. _____ FT.
 SAND _____
 GAS _____
 OIL _____
 TOTAL DEPTH 2880

PRODUCTION

1ST 24 HRS. NAT. _____
 1ST 24 HRS. AFTER SHOT _____
 GAS _____ Cu. Ft.
 DRY HOLE ✓
 ABANDONED ✓

DATE

5/30 192 3 SCOUT