

KANSAS


Barton

Form 51-5M-7-39-Palace

Section 5 Township 16 Range 13W

Well No. #2 Bitter "C"

Company Shell

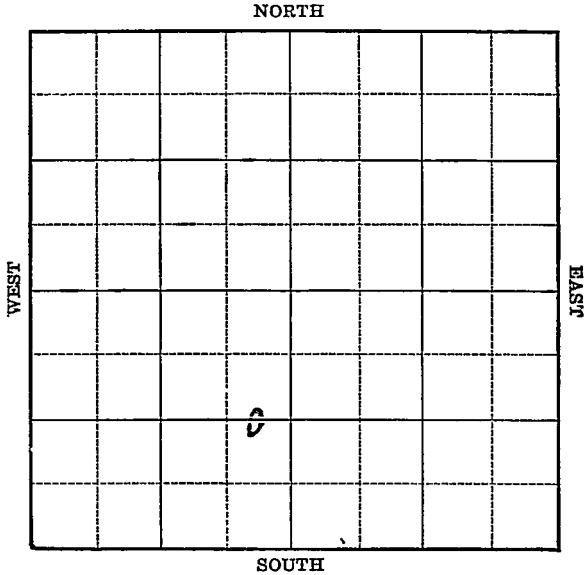

Sec. 5 Twp. 16 R. 13-W

Well No. #2 Bitter "C" Farm _____

Shell Company _____


(Trapp)

_____ Ft. from N. Line

1308 Ft. from S. Line

330 Ft. from E. Line

_____ Ft. from W. Line

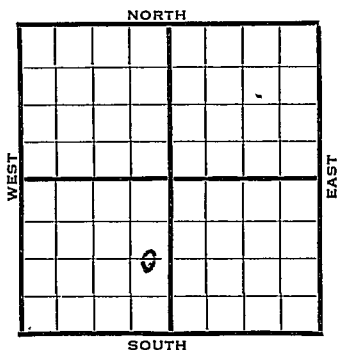

Elev. 1911

1940	REPORT
7/17	Derrick.
7/25	"
8/2	8" - 643' Drlg. 1328'
8/8	Drlg. 2825'
8/14	Topeka 2799- Arb. 3349-
	4 1/2" @ 3350
	T.D. 3351 R.U.S.T.
8/22	T.D. 3356' 1000 acid.
	Swab 266 bbls. oil 4 hours.
8/28	Arb. 3349 4" 3350
	T.D. 3356
	1000 acid
	Depthograph Pot. 9111
	Maximum 3000
	COMPLETED

Map No. _____ Sec. 5 Twp. 16 R. 13W

Well No. 2 Bitter "C"

Shell _____ Company

_____ Contractor

FIRST REPORT

C E L S^W

_____ Ft. from N. Line

1308 Ft. from S. Line

330 Ft. from E. Line

_____ Ft. from W. Line

SECTION PLAT

TRAPP POOL

Location _____

Rig up _____

Drilling and Remarks:

Derrick

RECORD

Cased _____ in., _____ ft.

Sand _____

Gas _____

Oil _____

Total Depth _____

PRODUCTION

1st 24 hrs. Nat. _____

1st 24 hrs. after shot _____

Gas _____ Cu. Ft.

Dry Hole _____

Abandoned _____

Date

JUL 17 1940

S. J. LEWIS Scout

KANSAS

Map No. _____ Sec. 5 Twp. 16 R. 13W

Well No. 2 Bitter "C"

Shell Company

Contractor

COMPLETED

C E L SW

SECTION PLAT

_____ Ft. from N. Line

1308 Ft. from S. Line

330 Ft. from E. Line

_____ Ft. from W. Line

TRAPP POOL

Location _____

Rig up _____

Drilling and Remarks:

Cor 83349

4" @ 3350

1000 cuol

Depth graph

9.11.11

Nov 8000

RECORD

Cased _____ in., _____ ft.

Sand _____

Gas _____

Oil _____

Total Depth 3356

PRODUCTION

1st 24 hrs. Nat. _____

1st 24 hrs. after shot _____

Gas _____ Cu. Ft.

Dry Hole _____

Abandoned _____

Date

AUG 28 1940

19

S. J. LEWIS

Scout