


Cowley

Section 3 Township 30 Range 4-E

Well No. 4 Shawver Ranch

Company E.B. Shawver

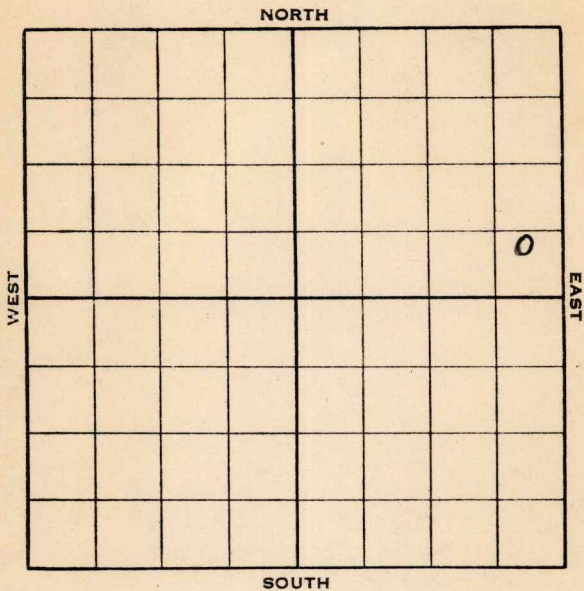

Sec. 3 Twp. 30 R. 4-E


Well No. #4 Shawver Ranch Farm  
E. B. Shawver Company

\_\_\_\_\_ Ft. from N. Line

550 Ft. from S. Line

330 Ft. from E. Line

\_\_\_\_\_ Ft. from W. Line

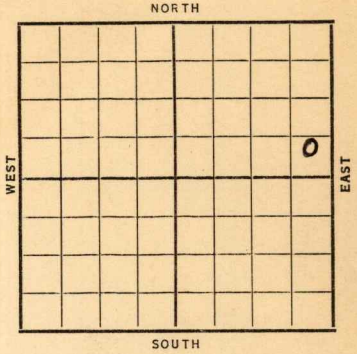

**Elev. 1262**

Date	REPORT
1938	
2/23	Location
3/4	Mat81.
3/11	Drlg. 1260'.
3/18	10" @ 97'. Drlg. 2770'.
3/25	7" @ 2809'1 No Bart.
	Drlg. 2860'.
3/30	7" @ 2809'.
	<b>No sand.</b>
	T.D. 2880'.

**ABANDONED**

Cowley

KANSAS

Map No. 11 Sec. 3 Twp. 30 R. 4E

Well No. 4 Shawver Ranch

E. B. Shawver Company

Contractor

FIRST REPORT

SECTION PLAT

SE NE

\_\_\_\_\_ Ft. from N. Line

550 Ft. from S. Line

330 Ft. from E. Line

\_\_\_\_\_ Ft. from W. Line

			0

Location X

Rig up \_\_\_\_\_

Drilling and Remarks:

RECORD

Cased \_\_\_\_\_ in., \_\_\_\_\_ ft.

Sand \_\_\_\_\_

Gas \_\_\_\_\_

Oil \_\_\_\_\_

Total Depth \_\_\_\_\_

PRODUCTION

1st 24 hrs. Nat. \_\_\_\_\_

1st 24 hrs. after shot \_\_\_\_\_

Gas \_\_\_\_\_ Cu. Ft.

Dry Hole \_\_\_\_\_

Abandoned \_\_\_\_\_

Date

FEB 23 1938 19

H. D. Hatfield Scout

Cowley

KANSAS

Map No. 11 Sec. 3 Twp. 30 R. 4E

Well No. 4 Shawver Ranch

E. B. Shawver

Company

Contractor

ABANDONED

SE NE

\_\_\_\_\_ Ft. from N. Line

550 Ft. from S. Line

330 Ft. from E. Line

\_\_\_\_\_ Ft. from W. Line

SECTION PLAT


Location \_\_\_\_\_

Rig up \_\_\_\_\_

Drilling and Remarks:

*DVA*

RECORD

Cased 7 in., 2809 ft.

Sand NO SAND

Gas \_\_\_\_\_

Oil \_\_\_\_\_

Total Depth 2880

PRODUCTION

1st 24 hrs. Nat. \_\_\_\_\_

1st 24 hrs. after shot \_\_\_\_\_

Gas \_\_\_\_\_ Cu. Ft.

Dry Hole \_\_\_\_\_

Abandoned \_\_\_\_\_

Date

MAR 30 1938

19

H. D. Hatfield

Scout