


KANSAS


Barton

Section.....5.....Township.....16.....Range.....13-W

Well Number.....#2 Bitter.....

Company.....Empire.....

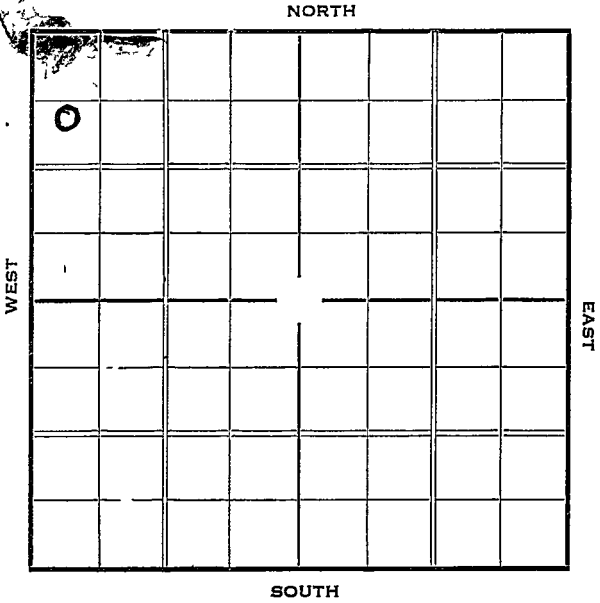

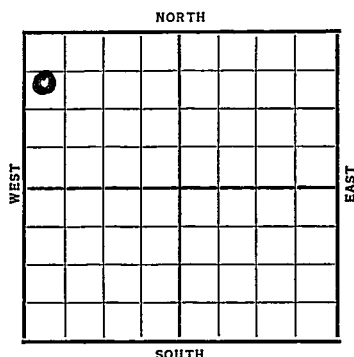Sec. 5 Twp. 16 R. 13-WWell No. #2 Bitter FarmEmpire Company1101701 Ft. from N. Line Ft. from S. Line Ft. from E. Line330 Ft. from W. Line

Date	REPORT
1937	
6/30	Location
7/9	"
7/16	Cellar.
7/23	R U R
7/30	10" @ 342'. Anhy 850'.
	Drlg. 1740'.
8/6	Drlg. 3074'.
8/13	Sil. & 7" @ 3202'. T.D. 3306'.
	RUST.
8/20	Pay 3307-10'. T.D. 3313'.
	2268' oil in 8 hrs.
8/25	7" @ 3302'
	Sil 3302'
	TD 3313'
	2000 acid
	Pot 1935
	COMPLETED

Barton KANSASMap No. _____ Sec. 5 Twp. 16 R. 13^WWell No. 2-BitterEmpire Company

Contractor

FIRST REPORT

SECTION PLAT

701 Ft. from N. Line

_____ Ft. from S. Line

_____ Ft. from E. Line

330 Ft. from W. Line

0			

Location ✓

Rig up _____

Drilling and Remarks:

RECORD

Cased _____ in., _____ ft.

Sand _____

Gas _____

Oil _____

Total Depth _____

PRODUCTION

1st 24 hrs. Nat. _____

1st 24 hrs. after shot _____

Gas _____ Cu. Ft.

Dry Hole _____

Abandoned _____

Date

JUN 30 1937 19 _____ H. D. Hatfield Scout

Barton KANSAS

Map No. _____ Sec. 5 Twp. 16 R. 13^W

Well No. 2 - Bitter

Empire Company

Contractor Completed well this week

CORRECTION -

SECTION PLAT

1101 Ft. from N. Line

_____ Ft. from S. Line

_____ Ft. from E. Line

330 Ft. from W. Line

0			

Location _____

Rig up _____

Drilling and Remarks:

*first reported
as being 701' from
north line -
should have been
1101*

RECORD

Cased _____ in., _____ ft.

Sand _____

Gas _____

Oil _____

Total Depth _____

PRODUCTION

1st 24 hrs. Nat. _____

1st 24 hrs. after shot _____

Gas _____ Cu. Ft.

✓ Dry Hole _____

Abandoned _____

Date

H. D. Hatfield

AUG 25 1937 19

Scout

Barton KANSAS

Map No. _____ Sec. 5 Twp. 16 R. 13^W

Well No. 2-Bitter

Empire Company

Contractor _____

COMPLETED correction Ticket **SECTION PLAT**

1101 Ft. from N. Line

_____ Ft. from S. Line

_____ Ft. from E. Line

330 Ft. from W. Line

0			

Location _____

Rig up _____

Drilling and Remarks:

2000 Acid

Pot-1935

RECORD

Cased 7 in., 3302 ft.

Sand sil 3302

Gas _____

Oil _____

Total Depth 3313

PRODUCTION

1st 24 hrs. Nat. _____

1st 24 hrs. after shot _____

Gas _____ Cu. Ft.

Dry Hole _____

Abandoned _____

Date

AUG 25 1937 19

H. D. Hatfield Scout