


Section 3 Township 30 Range 4-E

Well No. 2 - Shawver

Company E. B. Shawver

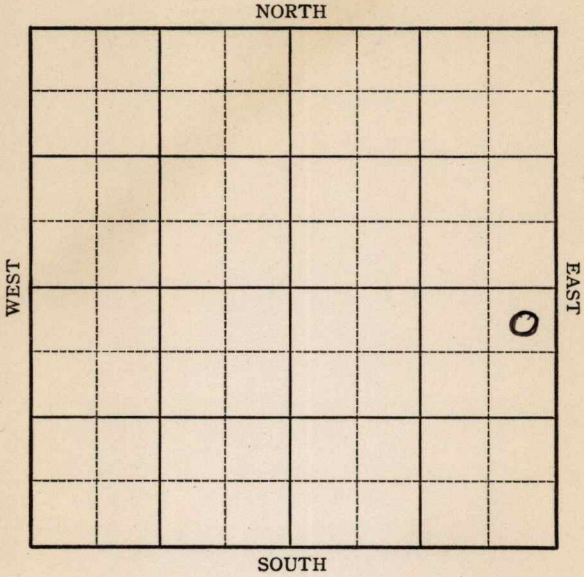

Sec. 3 Twp. 30 R. 4-E

Well No. #2 Shawver Farm


E.B. Shawver Company

330 Ft. from N. Line

_____ Ft. from S. Line

330 Ft. from E. Line

_____ Ft. from W. Line

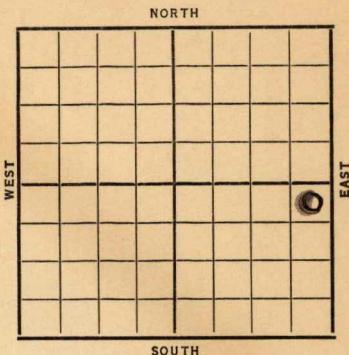

Elev. 1245

Date	REPORT
1937	
9/15	Location
9/24	R. up Mch.
	OVER

1937

11/23 6" @ 2770'.

5" Liner 2801'.

Bart. 2800'.

Potential 158 bbls.

COMPLETED

Cowley KANSAS

Map No. 11 Sec. 3 Twp. 30 R. 4E

Well No. 2-Shawver

E. B. Shawver Company

Contractor

FIRST REPORT

SECTION PLAT

330 Ft. from N. Line

Ft. from S. Line

330 Ft. from E. Line

Ft. from W. Line

			0

Location ✓

Rig up

Drilling and Remarks:

RECORD

Cased in., ft.

Sand

Gas

Oil

Total Depth

PRODUCTION

1st 24 hrs. Nat.

1st 24 hrs. after shot

Gas Cu. Ft.

Dry Hole

Abandoned

Date

SEP 15 1937

19

H. D. Hatfield

Scout

Cowley

KANSAS

Map No. 11 Sec. 3 Twp. 30 R. 4E

Well No. 2 Shawver

E. B. Shawver Company

Contractor

COMPLETED

NE SE

330 Ft. from N. Line

_____ Ft. from S. Line

330 Ft. from E. Line

_____ Ft. from W. Line

SECTION PLAT

			0

Location _____

Rig up _____

Drilling and Remarks:

POT-158

6" - 2770
RECORD
 5" Line 2801 ft.
 Cased _____ in., _____ ft.
 Sand *Bart* 2800
 Gas _____
 Oil _____
 Total Depth 2820

PRODUCTION

1st 24 hrs. Nat. _____
 1st 24 hrs. after shot _____
 Gas _____ Cu. Ft.
 Dry Hole _____
 Abandoned _____

Date

NOV 23 1937 19

H. D. Hatfield Scout