


Section 3 Township 30 Range 4-E

Well No. 5 Shawver Ranch

Company E. B. Shawver

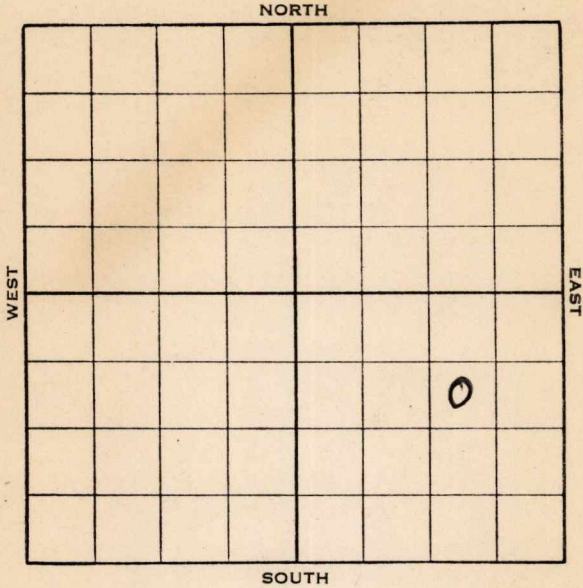

Sec. 3 Twp. 30 R. 4-E

Well No. #5 Shawver Ranch Farm

E. B. Shawver Company


990 Ft. from N. Line

_____ Ft. from S. Line

990 Ft. from E. Line

_____ Ft. from W. Line

Elev. 1232

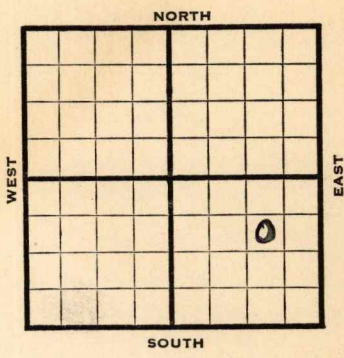

1938	REPORT
4/6	10" @ 78'. WOC.
4/15	T.D. 2240'.
4/22	7" @ 2770'. T.D. 2775'. RUST.
4/29	Drlg. 2796' no shows.
5/6	7" @ 2783'. Bart. 2799'.
	S.O. 2799-2803'. T.D. 2827'.
	700' oil. Shot 40 qts.
	Running liner.
5/12	" " "
5/20	Shut down.
5/27	" "
6/3	" "
6/8	7" @ 2783'.
	Bart. 2799'.
	T.D. 2827'.
	Shot 40 qts.
	Potential 210 bbls.
	COMPLETED

Cowley

KANSAS

Map No. 11 Sec. 3 Twp. 30 R. 4E

Well No. 5 Shawver Ranch

E. B. Shawver Company

Contractor

FIRST REPORT

SECTION PLAT

SW NE SE

990 Ft. from N. Line

_____ Ft. from S. Line

990 Ft. from E. Line

_____ Ft. from W. Line

			●

Location _____

Rig up _____

Drilling and Remarks:

10" - 78
WOC

RECORD

Cased _____ in., _____ ft.

Sand _____

Gas _____

Oil _____

Total Depth _____

PRODUCTION

1st 24 hrs. Nat. _____

1st 24 hrs. after shot _____

Gas _____ Cu. Ft.

Dry Hole _____

Abandoned _____

Date

APR 6 - 1938

19

H. D. Hatfield

Scout

Map No. 11 Sec. 3 Twp. 30 R. 4E

Well No. 5 Shawver Ranch

E. B. Shawver Company

Contractor

COMPLETED

SW NE SE

990 Ft. from N. Line

_____ Ft. from S. Line

990 Ft. from E. Line

_____ Ft. from W. Line

SECTION PLAT

			0

Location _____

Rig up _____

Drilling and Remarks:

SHOT 40 gts

POT 210

RECORD

Cased 7 in., 2783 ft.

Sand BART 2799

Gas _____

Oil _____

Total Depth 2827

PRODUCTION

1st 24 hrs. Nat. _____

1st 24 hrs. after shot _____

Gas _____ Cu. Ft.

Dry Hole _____

Abandoned _____

Date

JUN 8 - 1938

19

H. D. Hatfield

Scout