


Section 28 Township 33 Range 3E

Well No. 1 Wright

Company R.H. Shields et al

Misc.

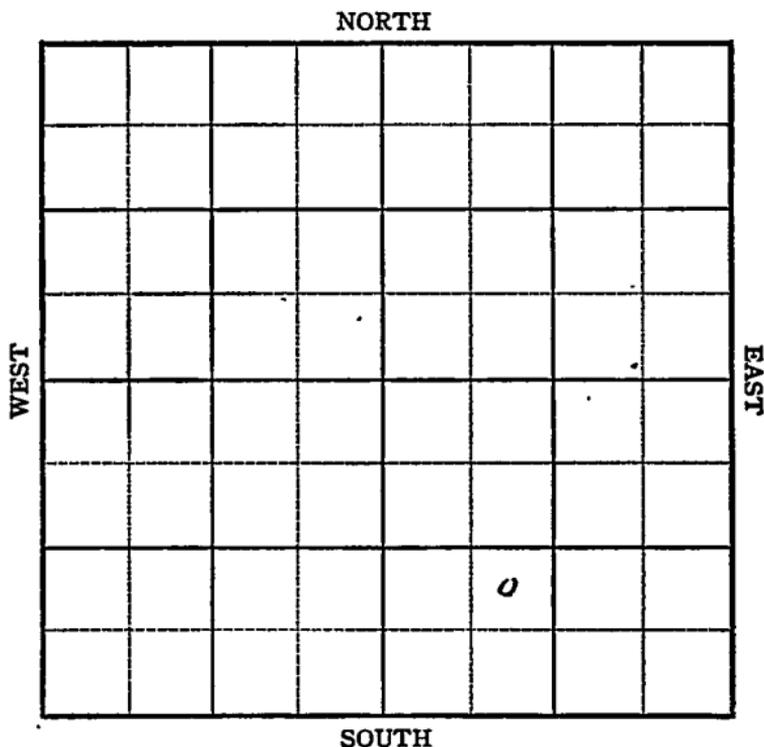



Sec. 28 Twp. 33 R. 3E

Well No. #1 Wright Farm

R. H. Shields Et al Company


Miscellaneous

_____ Ft. from N. Line

990' Ft. from S. Line

_____ Ft. from E. Line

990' Ft. from W. Line

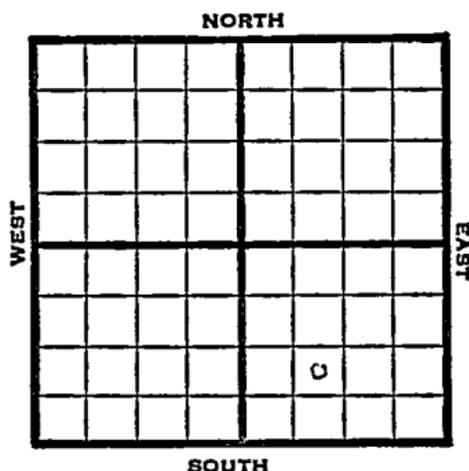

NE SW SE,

| 1949 | Elev 1114' REPORT |
|------------------|---|
| 3/2 | 8" @99' Drlg. 2802' |
| 3/8 | Lans 2772' Bart 3292' 5"@ 3278' Miss 3322-23' TD 3323' 80 qts CO/ |
| 3/16 | Swb 4 bbls oil PH - 3 hrs. |
| 3/23 | TD 3323' Bart 3292' Miss 3322' 5"@ 3278' 80 qts Pump 25 Oil Pot 38° Gr. Comp |
| COMPLETED | |

Map No. _____ Sec. 28 Twp. 33 R. 3E

Well No. 1 Wright

R. H. Shields et al. Company

FIRST REPORT

Contractor

NE SW SE

SECTION PLAT

_____ Ft. from N. Line

990 Ft. from S. Line

_____ Ft. from E. Line

990 Ft. from W. Line

| | | | |
|--|--|--|--|
| | | | |
| | | | |
| | | | |
| | | | |

Cowley County

Location _____

Rig up _____

Drilling and Remarks:

8" @ 99

drlg. 2802

RECORD

Cased _____ in., _____ ft.

Sand _____

Gas _____

Oil _____

Total Depth _____

PRODUCTION

1st 24 hrs. Nat. _____

1st 24 hrs. after shot _____

Gas _____ Cu. Ft.

Dry Hole _____

Abandoned _____

Date _____

MAR 10 1949 19.

S. J. LEWIS

Scout

Map No. 1 Sec. 28 Twp. 33 R. 3E

Well No. 1 Wright

R. H. Shields et al. Company

COMPLETE.

Contractor

NE SW SE

E. 1114
SECTION PLAT

_____ Ft. from N. Line

990 Ft. from S. Line

_____ Ft. from E. Line

990 Ft. from W. Line

| | | | |
|--|--|---|--|
| | | | |
| | | | |
| | | | |
| | | 8 | |

Cowley County

RECORD

Location _____

Cased _____ in., _____ ft.

Rig up _____

Sand _____

Drilling and Remarks:

Gas _____

Bar 3292.
Mis 3322

Oil _____

5" @ 3278.

Total Depth 3323

809 to.

PRODUCTION

1st 24 hrs. Nat. _____

1st 24 hrs. after shot _____

Gas _____ Cu. Ft.

Dry Hole _____

Abandoned _____

Pump 2500 ft. OK
CS 328

Date

MAR 23 1949 19

S. J. LEWIS

Scout