


Section 28 Township 33 Range 3 E

Well No. # 4-B Wright

Company Drillers Prod.

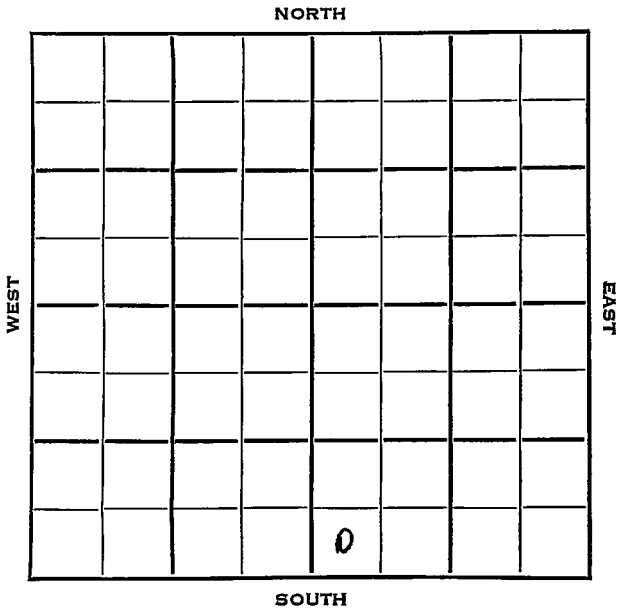



Sec. 28 Twp. 33 R. 3 E

Well No. # 4-B Wright Farm

Drillers Prod. Company

Contractor


Ft. from N. Line

330 Ft. from S. Line

Ft. from E. Line

330 Ft. from W. Line

SW SW SE

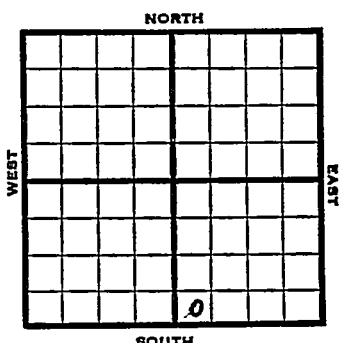

Elev. - REPORT

1953

6/10

Spud 6-7-53
10" @ 82
Drlg. 235

8/5

Spud 6-7-53 Oil well TD 3313
10" @ 82 Bart. 3273 Bart sd 3281
Miss 3311 TD 3313 7" @ 3313
Perf/3279-86 S/3 BOPH
Comp. 30 BOPD

COMPLETED

