


Section 28 Township 33 Range 3 E

Well No. # 5 Wright "B"

Company Drillers Prod.

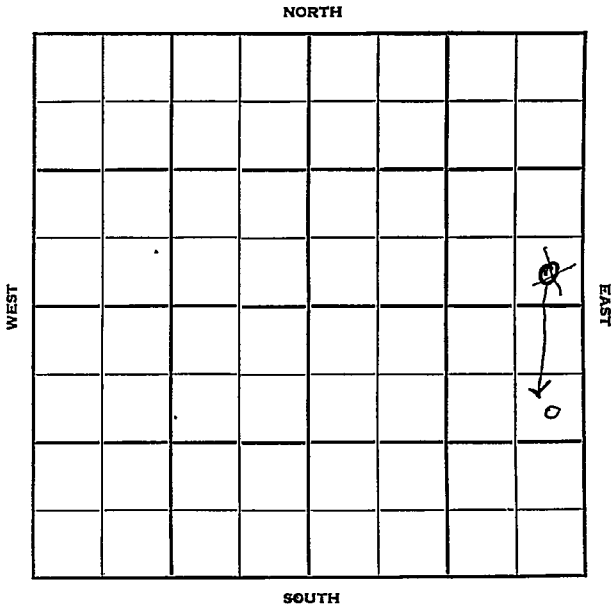



Sec. 28 Twp. 33 R. 3 E

Well No. # 5 Wright "B" Farm

Drillers Prod. Company

Drillers Prod. Contractor

Rainbow Bend Pool

990 Ft. from N. Line


~~330~~ Ft. from S. Line

330 Ft. from E. Line

_____ Ft. from W. Line

SE NE SE

~~SE SE NE~~

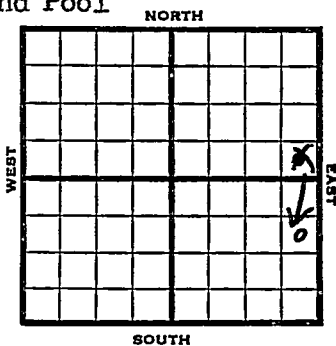

1953

Elev. 1137' REPORT

6/24

Spud 6-20-53

8" @ 97

Drlg. 250'

8/5

Spud 6-20-53 D & A TD 3365

8" @ 97 Lans 2200' Layton 2646

KC 2831 B KC 2943 Marm 3022

Cherokee 3140

TD 3365 D & A

ABANDONED

County Cowley State Kansas

Sec. 28 (Blk. 33 (Sur. 3E (Twp. 3E Map No.

Operator Drillers Prod.

Well No. 5 Farm Wright "B"

Elev. Location SE SE NE

330 Ft. From S Line NE

330 Ft. From E Line Quarter

1st. Report JUN 24 1953

Completion

Remarks

Drillers Prod. - Contr.

Spudding Date 6-20-53

Drlg. Data Rainbow Bend Pool

8" @ 97 drlg. 250

Kansas

Map No. _____ Sec. 28 Twp. 33 R. 3E

Well No. 5 Wright "B"

Drillers Prod. _____ Company

CORRELATION
 _____ Contractor

SE NE SE

SECTION PLAT

990 Ft. from N. Line

_____ Ft. from S. Line

330 Ft. from E. Line

_____ Ft. from W. Line

			o

Cowley County

Location _____

Rig up _____

Drilling and Remarks:

Reported
 SE SE NE

RECORD

Cased _____ in., _____ ft.

Sand _____

Gas _____

Oil _____

Total Depth _____

PRODUCTION

1st 24 hrs. Nat. _____

1st 24 hrs. after shot _____

Gas _____ Cu. Ft.

Dry Hole _____

Abandoned _____

Date

Jul 1 1953

19

J. G. McGEHEE Scout

County Cowley State Kansas

Sec. 28 (Blk. 33) (Sur. 3E) (Twp. 33) (Rge. 3E) Map No.

Operator Drillers Prod.

Well No. 5 Farm Wright "B"

Elev. 1137 Location SE NE SE

990 Ft. From N Line SE

330 Ft. From E Line Quarter

1st. Report

Completion AUG 3 1953

Remarks Rainbow Bend Pool

Drillers Prod. - Contr.

Spudding Date 6-20-53

Drlg. Data D & A TD 3365

8" @ 97 Lans. 2200 Layton 2646

KC 2831 B KC 2943 Marm. 3022

Cherokee 3140 TD 3365

D & A