


Cowley

KANSAS

Section 3 Township 30 Range 4-E

Well No. 7 Shawver Ranch

Company Shawver

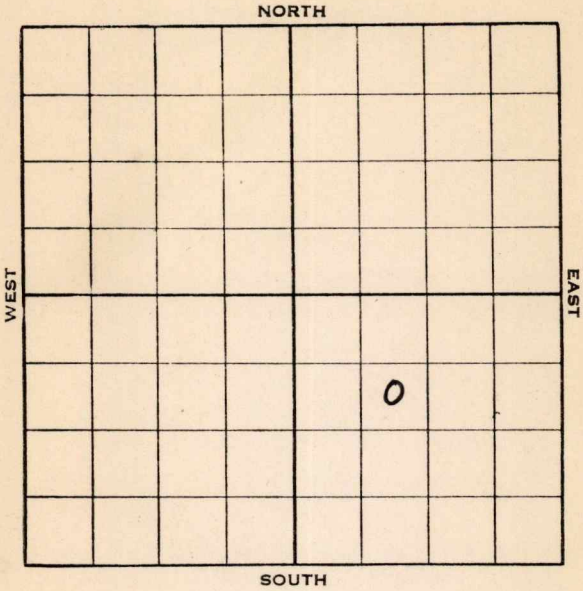

Sec. 3 Twp. 30 R. 4-E

Well No. #7 Shawver Ranch Farm


Shawver Company

990 Ft. from N. Line

_____ Ft. from S. Line

_____ Ft. from E. Line

990 Ft. from W. Line

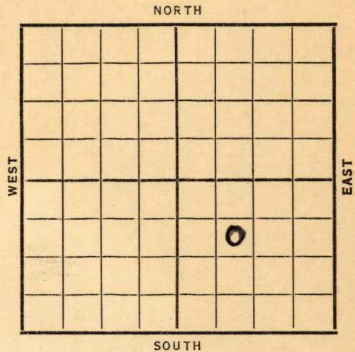

Date	REPORT
1938	
7/27	Drlg. 1500'.
8/5	10" - 80'. 7" - 2795'.
	Bart. 2818'. Dlg. 2820'.
	No shows.
8/12	Miss. 2905'. T.D. 2924'.
	Cleaning out.
8/19	Dlg. 3095'.
8/24	7" at 2795'.
	Arb. 3325'.
	T. D. 3329'.
	H. F. W. 3326-29'.
	ABANDONED

Cowley

KANSAS

Map No. 11 Sec. 3 Twp. 30 R. 4E

Well No. 7 Shawver Ranch

Shawver

Company

Contractor

FIRST REPORT

SE NW SE

990 Ft. from N. Line

_____ Ft. from S. Line

_____ Ft. from E. Line

990 Ft. from W. Line

SECTION PLAT

		0	

Location _____

Rig up _____

Drilling and Remarks:

Drlg. 1500

RECORD

Cased _____ in., _____ ft.

Sand _____

Gas _____

Oil _____

Total Depth _____

PRODUCTION

1st 24 hrs. Nat. _____

1st 24 hrs. after shot _____

Gas _____ Cu. Ft.

Dry Hole _____

Abandoned _____

Date

JUL 27 1938

H. D. Hatfield Scout

Cowley

KANSAS

Map No. 11 Sec. 3 Twp. 30 R. 4E

Well No. 7 Shawver Ranch

Shawver

Company

Contractor

ABANDONED

SECTION PLAT

SE NW SE

990 Ft. from N. Line

_____ Ft. from S. Line

_____ Ft. from E. Line

990 Ft. from W. Line

		0	

Location _____

Rig up _____

Drilling and Remarks:

HFW 3326-29

DVA

RECORD

Cased 7 in., 2795 ft.

Sand ARB 3325

Gas _____

Oil _____

Total Depth 3329

PRODUCTION

1st 24 hrs. Nat. _____

1st 24 hrs. after shot _____

Gas _____ Cu. Ft.

Dry Hole _____

Abandoned _____

Date

AUG 24 1938

19

H. D. Hatfield Scout