

KANSAS


FORM 51 5M 4-41 PETROL

Cowley

Section 3 Township 30 Range 4-E

Well No. 8 Shawver ranch

Company E.B. Shawver

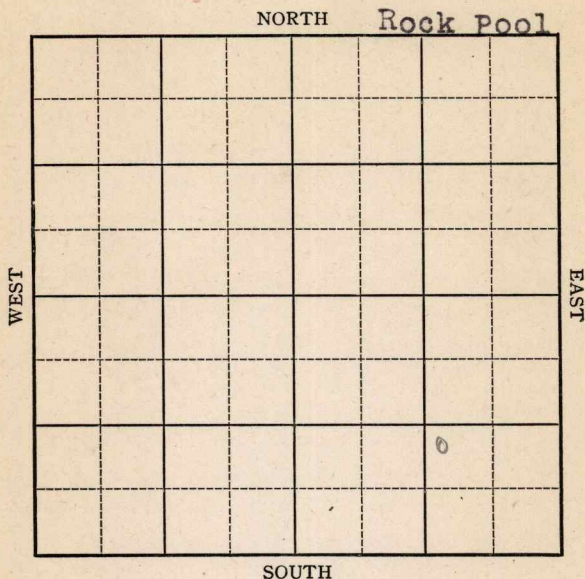

Sec. 3 Twp. 30 R. 4-E

Well No. #8 Shawver Ranch Farm

E. B. Shawver Company


(Rock)

_____ Ft. from N. Line

990 Ft. from S. Line

990 Ft. from E. Line

_____ Ft. from W. Line

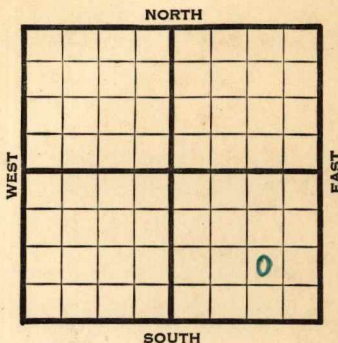

Elev. 1225

1941	REPORT
9/17	12" - 72'
	Drlg. 280'
9/25	Drlg. 2280'
10/2	Bart. 2787-94' T.D.
	7" - 2787' WOC.
10/8	Bart. 2787'
	7" - 2787'
	T.D. 2855'
	Water.
	ABANDONED

Cowley

KANSAS

Map No. K-11 Sec. 3 Twp. 30 R. 4E

Well No. 8 Shawver Ranch

E. D. Shawver Company

ABANDONED Contractor

NW SE SE

SECTION PLAT

			o

_____ Ft. from N. Line

990 Ft. from S. Line

990 Ft. from E. Line

_____ Ft. from W. Line

ROCK POOL

Location _____

Rig up _____

Drilling and Remarks:

Bar Y 2787

7" @ 2787

Water

RECORD

Cased _____ in., _____ ft.

Sand _____

Gas _____

Oil _____

Total Depth 2855

PRODUCTION

1st 24 hrs. Nat. _____

1st 24 hrs. after shot _____

Gas _____ Cu. Ft.

Dry Hole _____

Abandoned _____

Date

OCT 8 1941 19

S. J. LEWIS Scout