


Section 2 Township 15 Range 14W

Well No. #11 Michel (A)

Company N. C. R. A.

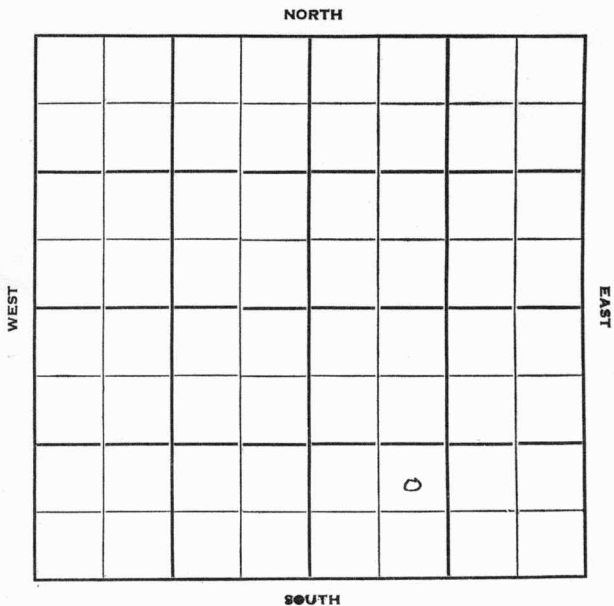

Russell

KANSAS

Sec. 2 Twp. 15 R. 14W

Well No. #11 Michel (A) Farm

N. C. R. A. Company

Brunsen - CONTR. Contractor


Ft. from N. Line

990' Ft. from S. Line

Ft. from E. Line

990' Ft. from W. Line


NE SW SE

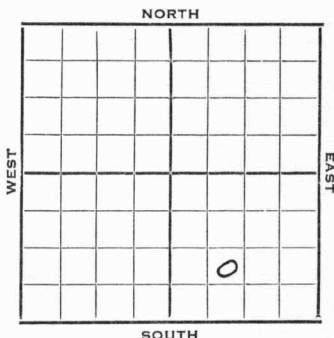

1951	Elev. 1711' REPORT
12/19	Spud 12-12-51 Drlg. 1800'
1952 1/30	Spud 12-12-51 Oil Well TD 2322 10" @ 745 Tarkio 2304-06 7" @ 2305 TD 2311 B/ 1 goph DD 2322 B/ 45 go 14 hr. PB 2315 Hydro. S/ 30 bo 7½ bw 15 hr. S/ 13 bo 6 bw 2 hr. Comp. 87 bopd 20% wtr.

COMPLETED

County Russell State Kansas
Sec. 2 (Blk.) 15 (Sur.) 14W Map No.
Operator N. C. R. A.
Well No. 11 Farm Michel (A)
Elev. _____ Location NE SW SE

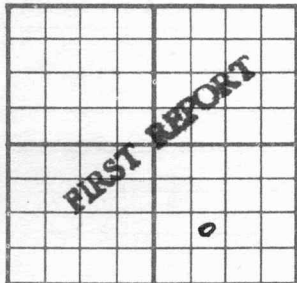

990 Ft. From S Line SE
990 Ft. From W Line _____ Quarter
1st. Report DEC 1 0 1951

Completion _____

Remarks _____

Brunsen - Contr.


Spudding Date 12-12-51

Drlg. Data _____

Drlg. 1800

J. E. TYRA

County Russell State Kansas
 Sec. 2 (Blk.) 15 (Sur. Rge.) 14W Map No.
 Operator N C R A
 Well No. 11 Farm Michel "A"
 Elev. 1711 Location NE SW SE

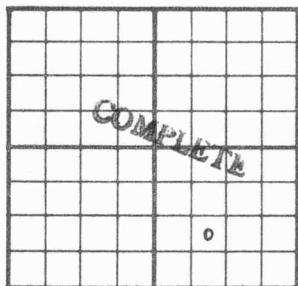

990 Ft. From S Line SE
990 Ft. From W Line Quarter

1st. Report

Completion JAN 3 1952

Remarks

Brunson Drlg. - Contr.

Spudding Date 12-12-51

Drlg. Data Oil well TD 2322

10" @ 745 Tarkio 2304-06 7" @ 2305

TD 2311 B/ 1 goph DD 2322 B/ 45 go

14 hr. PB 2315 Hydro. S/ 30 bo

7 $\frac{1}{2}$ bw 15 hr. S/ 13 bo 6 bw 2 hr.

Comp. 87 bopd 20% water

J. G. McGEHEE