


Section 3 Township 30 Range 4E

Well No. #9 Shawver Ranch

Company E.B. Shawver

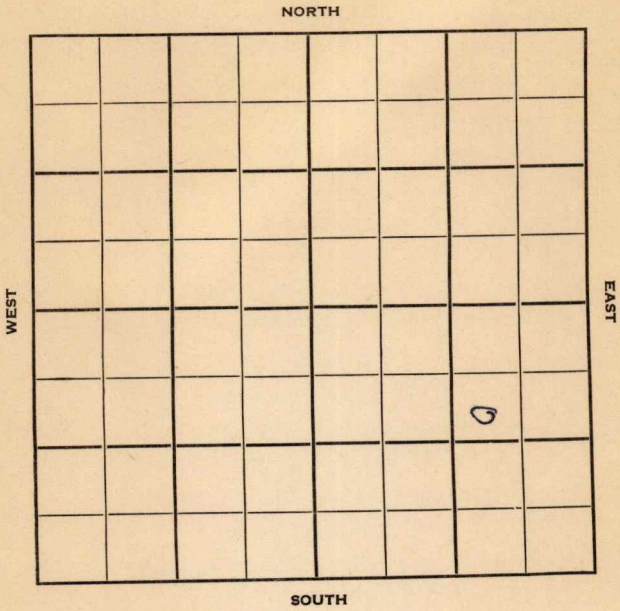

Cowley

KANSAS



Sec. 3 Twp. 30 R. 4E

Well No. #9 Shawver Ranch Farm

E. B. Shawver Company

Contractor

N. Rock Pool


1090 Ft. from N. Line

Ft. from S. Line

990 Ft. from E. Line

Ft. from W. Line

SE 1/4 SW NE SE

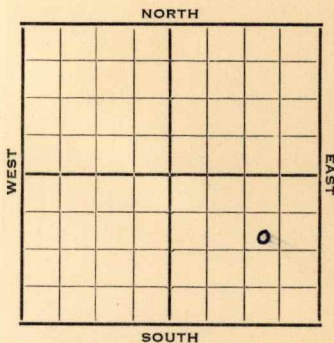

1952 Elev. 1240' REPORT

10/29 RUR

12/3 Spud 10-29-52

Abd.

TD 2821

8" @ 61

Bart 2794

TD 2797

5" @ 2794

DD2807

DD 2821

Shut down for orders

Abd.

ABANDONED

County Cowley State Kansas

Sec. 3 (Blk. 30 (Sur. 4E (Twp. Map No. Rge.)

Operator E. B. Shawver

Well No. 9 Farm Shawver Ranch

Elev. 1240 Location SW NE SE

1090 Ft. From N Line SE

990 Ft. From E Line Quarter

Ist. Report

Completion DEC 3 1952

Remarks N. Rock Pool

Spudding Date 10-29-52

Drlg. Data Abd. TD 2821

8" @ 61 Bart, 2794 TD 2797

5" @ 2794 DD 2807 DD 2821

shut down for orders

Abd.

