

FORM 51


Cowley

KANSAS

Section 28 Township 33 Range 3E

Well No. #2 Moldenhauer

Company K. T. Weidemann

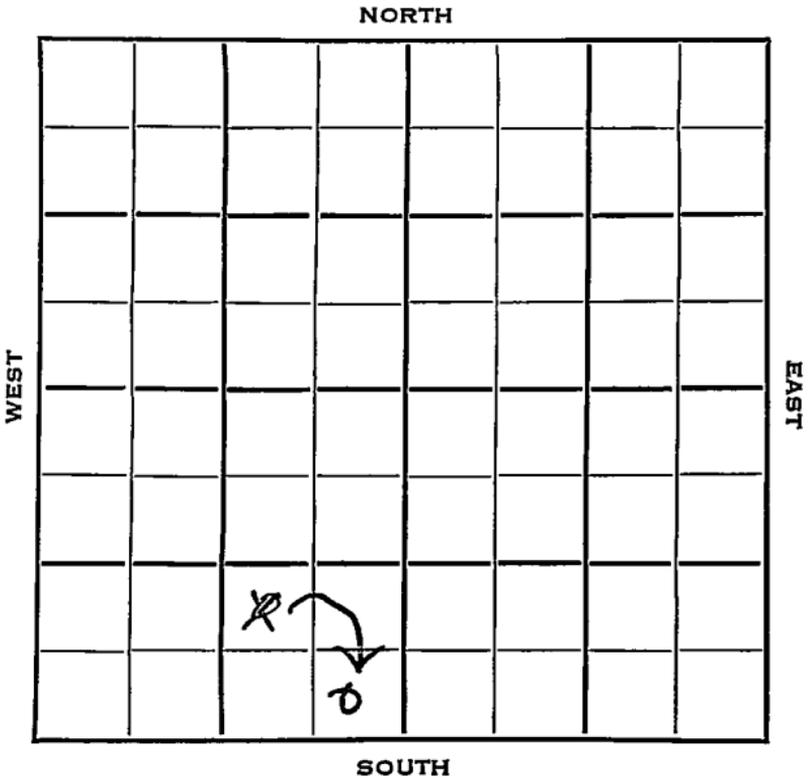

Cowley

KANSAS ✓

Sec. 28 Twp. 33 R. 3 E

Well No. # 2 Moldenhauer Farm

K. T. Weidemann Company

Weidemann Contractor

Rainbow Bend Pool


430 Ft. from N. Line

~~990~~ Ft. from S. Line

330 Ft. from E. Line

~~990~~ Ft. from W. Line

~~SE~~
~~NW~~ SE SW

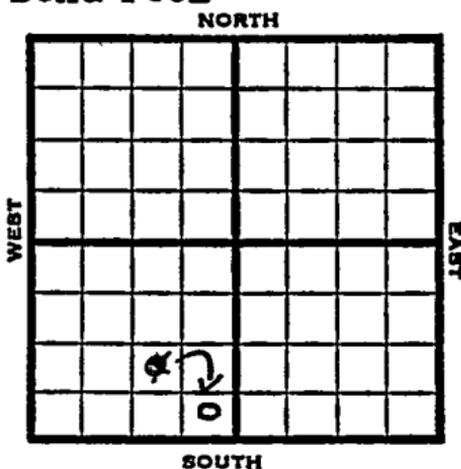

1953 Elev. 1113' REPORT

3/25 Spud 3-22-53
8" @ 95'

7/15 Spud 3-22-53
D & A
TD 3321'
8" @ 95'
Layton 2612, KC 2792, B KC 2903,
Marm 2985, Bart 3281
TD 3291'
5" @ 3291'
DD 3321
SO 3316-21 Miss 3309
D & A

ABANDONED

Kansas

Map No. _____ Sec. 28 Twp. 33 R. 3EWell No. 2 Moldenhauer

K. T. Weidemam _____ Company

CORRECTION

Contractor

SE SE SW

SECTION PLAT

_____ Ft. from N. Line

430 Ft. from S. Line330 Ft. from E. Line

_____ Ft. from W. Line

Cowley County

Location _____

Rig up _____

Drilling and Remarks:

Reported

NW SE SW

RECORD

Cased _____ in., _____ ft.

Sand _____

Gas _____

Oil _____

Total Depth _____

PRODUCTION

1st 24 hrs. Nat. _____

1st 24 hrs. after shot _____

Gas _____ Cu. Ft.

Dry Hole _____

Abandoned _____

Date

APR 1 1953

19

J. G. McGEHEE

Scout

