

FORM 51


Cowley

KANSAS

Section 28 Township 33 Range 3E

Well No. #2 Wright "B"

Company Drillers Producing Company

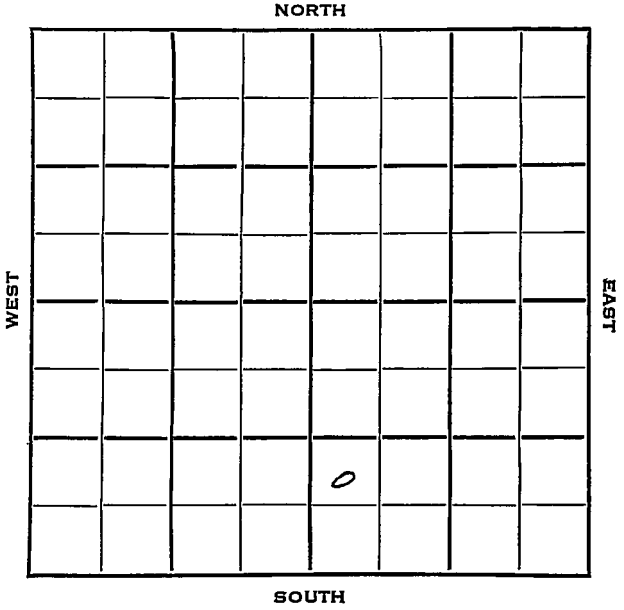

Cowley

KANSAS ✓

Sec. 28 Twp. 33 R. 3E

Well No. #2 Wright "B" Farm

Drillers Producing Company

Springer & Harper - Contr. Contractor

Rainbow Pool


Ft. from N. Line

990 Ft. from S. Line

Ft. from E. Line

330 Ft. from W. Line

NW SW SE

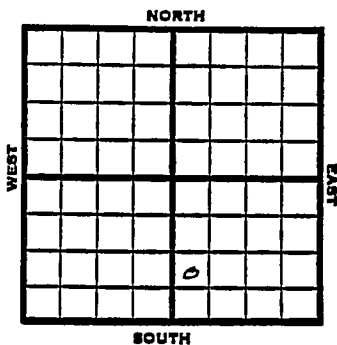

1953 Elev. 1113' REPORT

3/4  
4/15

Location  
Spud 3-11-53  
Oil Well  
TD 3311'  
8" @ 90'  
Stal. 2204, Lans. 2695, Layton 2608,  
KC 2797, B KC 2912, Marm 2988,  
Cherokee 3105, Bart 3259, Bart sd 3283,  
TD 3311  
5" @ 3298'  
CO to 3308  
sd-frac S/ 65 bw 45 bo 12 hr.  
Comp. 90 bopd 130 bw

**COMPLETED**



