

Section 6 Township 30 Range 4-E

Well No. #1 Brodbeck

Company McNish & Grallop

NORTH

WEST

EAST

0

SOUTH

Cowely

KANSAS

Sec. 6 Twp. 30 R. 4E

Well No. #1 Brodbeck Farm

McNish & Grallop Company

Watson - Contr. Contractor

Wildcat


_____ Ft. from N. Line

990' Ft. from S. Line

_____ Ft. from E. Line

330' Ft. from W. Line

NW SW SE

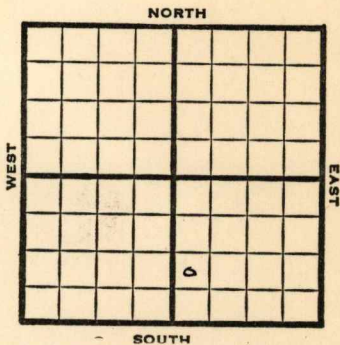

1950

Elev 1169' REPORT

11/8

8" @ 95'

12/6

8" @ 95'

Iton 1872

Stal 1876

KC 2246

Miss 2968

Arb 3119-35 TD

TD 3135'

D&A

ABANDONED


County Cowley State Kansas

Sec. 6 (Blk. 30 (Sur. 4E (Twp.) 30 (Rge.) 4E Map No.

Operator McNish & Grallop

Well No. 1 Farm Brodbeck

Elev. 1169 Location NW SW SE

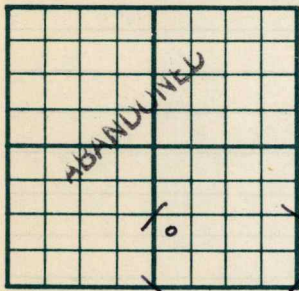

990 Ft. From S Line SE

330 Ft. From W Line Quarter

1st. Report

Completion DEC 6 1950

Remarks Wildcat

Watson - Contr.

Spudding Date

Drlg. Data D & A TD 3135

8" @ 95 Iton 1872 Stal. 1876

KC 2246 Miss. 2968 Arb. 3119-35 TD

D & A

J. E. TYRA