

KANSAS

Form 51-5M-7-39-Palace

Barton

O.W.F.B.

Section 5 Township 16 Range 13-W

Well No. #5 Ditter "A"


Company Cities Service Oil

NORTH

Trapp Pool

WEST

EAST

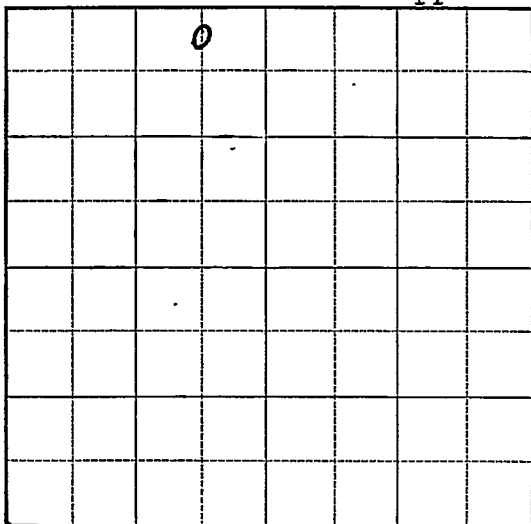

SOUTH

KANSAS O. W. P. Barton

Sec. 5 Twp. 16 R. 13-W

Well No. #5 Bitter "A" Farm

Cities Service Oil Company

(Trapp)


330 Ft. from N. Line

Ft. from S. Line

660 Ft. from E. Line

Ft. from W. Line

Elev. 1875

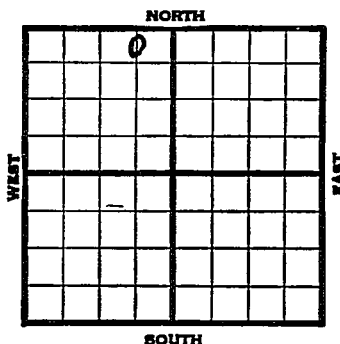

1940

REPORT

2/28

Location

3/8

8-5/8" - 325' Drlg. 917'

3/14

Drlg. 2926'

3/21

Lans. 3061' Arb. ³³¹² ~~3315~~-16' T.D.5" - ³³¹² ~~3316~~' RUST.

3/28

" " "

4/3

Arb. 3312'

5" - 3312'

T.D. 3320'

2000 acid.

Echometer potential 784 bbls.

1954

COMPLETED

O. W. P. B.

5/26

OIL Well

TD 3320'

Lans 3061', Arb 3312'

5" @ 3313'

OTD 3320'

PB 3166

12/ 3081'-92 6/ 3092-97 18/ 3085-91

18/ 3091-97 2000 A

Comp 2 bopd. 23 by

FIRST REPORT
COMPLETED

Map No. 73 Sec. 5 Twp. 16 R. 13WWell No. 5 Bitter "A"

Cities Service Oil

Company

Contractor

FIRST REPORT

C N L NE NW

330 Ft. from N. Line Ft. from S. Line660 Ft. from E. Line Ft. from W. Line

SECTION PLAT

	0		

TRAPP POOL

Location XRig up

Drilling and Remarks:

RECORD

Cased in., ft.Sand Gas Oil Total Depth

PRODUCTION

1st 24 hrs. Nat. 1st 24 hrs. after shot Gas Cu. Ft.Dry Hole Abandoned

Date

FEB 28 1940

19

S. J. LEWIS

Scout

Barton KANSAS

Map No. 72 Sec. 5 Twp. 16 R. 13WWell No. 5 Bitter "A"Cities Service Oil CompanyCOMPLETED Contractor

C N L NE NW

SECTION PLAT

	o		

330 Ft. from N. Line Ft. from S. Line660 Ft. from E. Line Ft. from W. Line

TRAPP POOL

Location Rig up

Drilling and Remarks:

*Ar & 3312**5' @ 3312**2000 acid**Echometer Rx**784*

RECORD

Cased in., ft.Sand Gas Oil Total Depth 3320

PRODUCTION

1st 24 hrs. Nat. 1st 24 hrs. after shot Gas Cu. Ft.Dry Hole Abandoned

Date

APR 3 1940 19 S. J. LEWIS Scout

O.W.P.B.

County Barton State KansasSec. 5 (Blk.) 16 (Sur.) 13W Map No.Operator Cities ServiceWell No. 5 Farm Bitter "A"Elev. 1875 Location C N $\frac{1}{2}$ NE NW

FIRST REPORT

COMPLETE

330 Ft. From N Line NW660 Ft. From E Line Quarter

MAY 26 1954

1st. Report

O.W.P.B. MAY 26 1954

Remarks

OWPB

Spudding Date

Drig. Data Oil well TD 3320Lens. 3061 Arb. 3312 5" @ 3313OTD 3320 PB 3166 12/ 3081-92 6/ 3092-97 18/ 3085-91 18/ 3091-97 2000 AComp. 2 bopd 23 bw

J. G. McGEHEE