


Section 2 Township 15 Range 11W

Well No. #12 Flegler "B"

Company N C R A

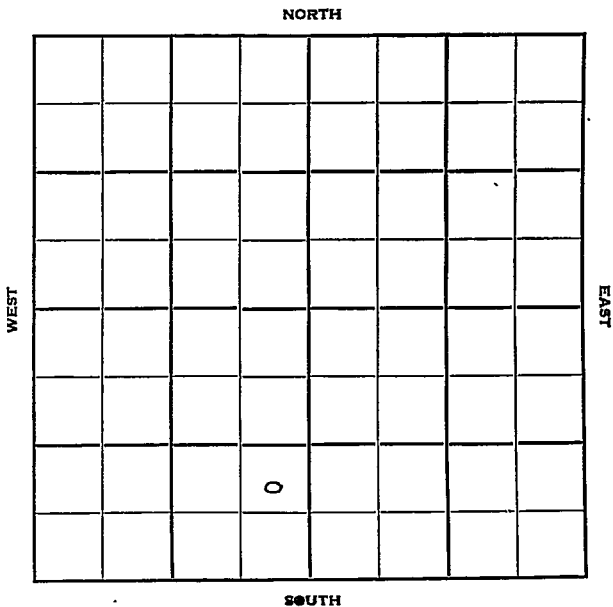

Russell

KANSAS

Sec. 2 Twp. 15 R. 14W

Well No. #12 Flegler "B" Farm

N C R A

Company

Carter Drlg. - Contr.

Contractor


Ft. from N. Line

NORTH

990' Ft. from S. Line

330' Ft. from E. Line

Ft. from W. Line

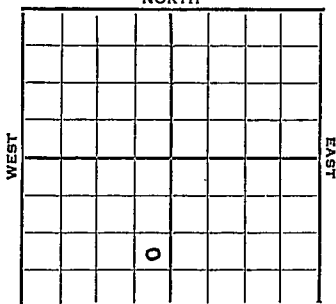

NE SE SW

SOUTH

1951

Elev. 1711'

REPORT

12/12

Spud 12-9-51

15" @ 43

Drlg. 120'

1952

2/6

Spud 12-9-51

Oil Well TD 2286

15" @ 43

13" @ 375

10" @ 720

8" @ 2210

Tarkio 2279 7" @ 2280

TD 2285 DD 2286 B/ 19 go 5 hr.


Hydro. S/ 15 bo 8 hr. S/ 1½ boph

S/ 7½ boph 10% wtr.

Comp. 89 bopd 31 bw

COMPLETED

County Russell State Kansas
 Sec. 2 (Blk. Twp.) 15 (Sur. Rge.) 14W Map No. _____
 Operator N C R A
 Well No. 12 Farm Flegler "B"
 Elev. _____ Location NE SE SW

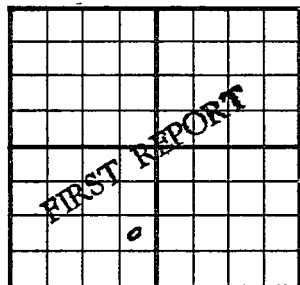

990 Ft. From S Line SW
330 Ft. From E Line Quarter
 1st. Report DEC 1 2 1951
 Completion _____
 Remarks _____
Carter Drlg. - Contr.
 Spudding Date 12-9-51

Drlg. Data

15" @ 43 drlg. 120

J. E. TYRA

J. G. McGEHEE