

KANSAS WELL LOG BUREAU --- KANSAS GEOLOGICAL SOCIETY

508 EAST MURDOCK - WICHITA, KANSAS


COMPANY WATSON DRILLING COMPANY

SEC. 6 T. 30 R. 4E

FARM Brodbeck NO. 1

LOC. NW SW SE

TOTAL DEPTH 3135  
 COMM. 11-18-50 COMP. 12-2-50  
 SHOT OR TREATED  
 CONTRACTOR  
 ISSUED 12-23-50

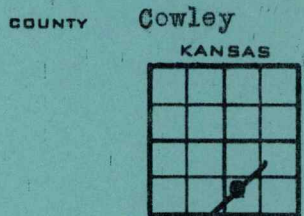

CASING

ELEVATION 1169 *Ind*  
 PRODUCTION dry

FIGURES INDICATE BOTTOM OF FORMATIONS.

surface	90	lime	2979
lime	130	lime cherty	3005
lime & shale	179	lime white	3035
redrock	184	lime	3069
lime & shale	235	shale	3119
redrock	245	cherty lime	3124
lime	255	lime	3135
lime & shale	400	Total depth	
redrock	410		
lime & shale	440	Tops:	(Scout)
shale & shells	665	Brown lime	1872
shale & lime shells	850	Stalnaker	1876
lime	865	Kansas City	2246
shale & lime	1160	Mississippi	2850
shale & lime shells	1220	Arbuckle	3119
broken shale & lime	1230		
lime	1265		
lime & shale	1310		
lime	1330		
shale & lime	1635		
redrock	1640		
shale & lime	1755		
shale	1872		
lime	1876		
sand	1905		
sdv shale & lime	1961		
sdv shale	1980		
sand & sdv shale	2008		
lime & shale	2065		
sand & shale	2110		
lime, shale & sand strks	2130		
lime & shale	2174		
shale sdv	2247		
K.C. Lime top	2246		
K. C. Lime	2390		
sand	2423		
sdv shale	2445		
lime	2454		
lime	2455		
shale	2475		
shale & lime strks	2495		
shale & lime	2565		
lime	2581		
lime & shale	2747		
shale	2781		
lime	2790		
shale	2808		
sand & shale	2839		
Miss. lime blk	2850-2895		
white lime	2949		

*Handwritten:*  
 2747  
 1169  
 ---  
 1578