


Map No. K Sec. 29 Twp. 33 R. 3^E
Well No. 1 Beatty (Beebe) Farm
W. Phillips Company

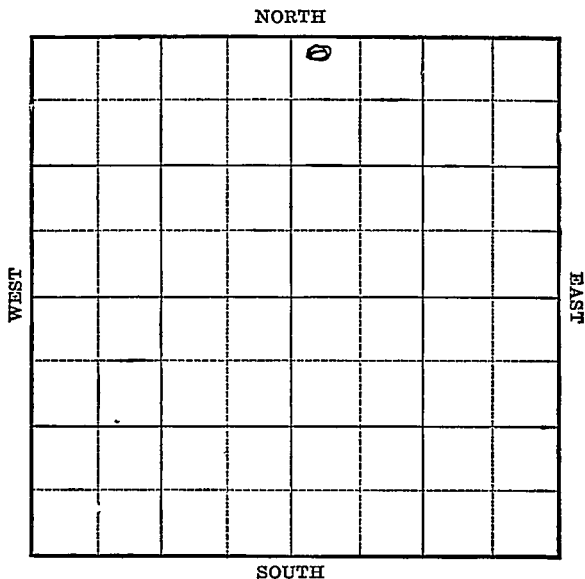

Location _____

Rig Up _____

Drilling Remarks:

Drilling Remarks:

RECORD

PRODUCTION

Cased _____ in. _____ ft.

1st 24 hrs. Nat. _____

Sand _____

1st 24 hrs. after shot _____

Gas _____

Gas _____ cu. ft.

Oil _____

Dry Hole _____

Total Depth _____

Abandoned _____

Map No. K Sec. 29 Twp. 33 R. 3E


Well No. 1 Beatty Farm
W. Phillips Company

330 Ft. from N. Line

_____ Ft. from S. Line

_____ Ft. from E. Line

330 Ft. from W. Line

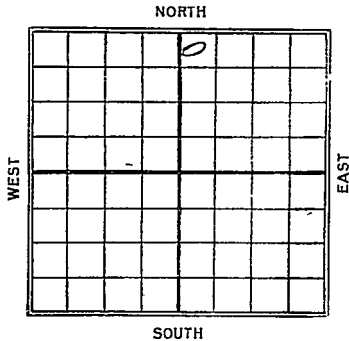

Date	REPORT
1924	
11/6	Timbers
11/26	Spudding
12/17	4 Alg. @ 80.0
1925	
11/21	Sly 28.00
2/13	Sand 3232-3276 m/cy 100 Bbl Shot 5 + 10 gts now flowing 200 or 300 Bbl per day 1st well shot in W. Phillips Pool (Full)
3/11	Sand 3232-76 Shot 5-10 + 20 gts Swabbing 130 Bbl

Map No. **KANSAS** Sec. *29* Twp. *33* R. *3^E*Well No. *1 Beatty**Walter P. Phillips* Company

Contractor

FIRST REPORT

SECTION PLAT

330 Ft. from N. Line

----- Ft. from S. Line

----- Ft. from E. Line

330 Ft. from W. Line

		0	

Location -----

Rig up -----

Drilling and Remarks:

Timbers

RECORD

Cased ----- in., ----- ft.

Sand -----

Gas -----

Oil -----

Total Depth -----

PRODUCTION

1st 24 hrs. Nat. -----

1st 24 hrs. after shot -----

Gas ----- Cu. Ft.

Dry Hole -----

Abandoned -----

Date

NOV 6 1924

M. A. BENEAR

192

Scout

Map No. **KANSAS** Sec. 29 Twp. 33 R. 3

Well No. 1 Beatty

Walter Phillips Company

Contractor

COMPLETED

SECTION PLAT

330 Ft. from N. Line

_____ Ft. from S. Line

_____ Ft. from E. Line

330 Ft. from W. Line

		0	

Location _____

Rig up _____

Drilling and Remarks:

*small 32 32-76
shot 5-10 x 20 gts
swabbing 130 ft*

RECORD

Cased _____ in., _____ ft.

Sand _____

Gas _____

Oil _____

Total Depth _____

PRODUCTION

1st 24 hrs. Nat. _____

1st 24 hrs. after shot _____

Gas _____ Cu. Ft.

Dry Hole _____

Abandoned _____

Date

3/1 1923

M. A. BENEAR

Scout