

Cowley

Map No. *Kansas* Sec. *29* Twp. *33* R. *3*


Well No. *3 Beaty* Farm
Waite Phillips Company

330 Ft. from N. Line

..... Ft. from S. Line

990 Ft. from E. Line

..... Ft. from W. Line

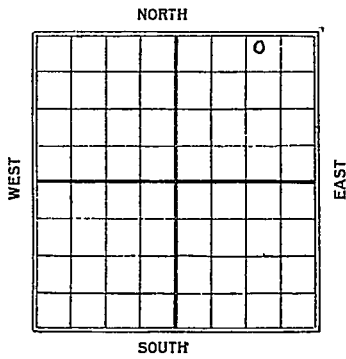

Beneas

Date
1925

REPORT

3/3 Location

6/3 F 3230 F.O. 3236 B.S. 3268 T.D. 3264

945 bbls. 1st 24 hrs

Map No. **KANSAS** Sec. *29* Twp. *33* R. *3*

Well No. *3 Beatty*

Waitt Phillips Company

Contractor

COMPLETED SECTION PLAT

330' Ft. from N. Line

_____ Ft. from S. Line

990' Ft. from E. Line

_____ Ft. from W. Line

			0

Location _____

Rig up _____

Drilling and Remarks:

Top o. 3230'

70. 3236

Bottom o. 3268

70. 3269

945 110

101 12 hrs.

RECORD

Cased _____ in., _____ ft.

Sand _____

Gas _____

Oil _____

Total Depth _____

PRODUCTION

1st 24 hrs. Nat. _____

1st 24 hrs. after shot _____

Gas _____ Cu. Ft.

Dry Hole _____

Abandoned _____

Date

JUN 5 1925

M. A. BENEAR

_____ 192_____

Scout