

KANSAS

Map No. _____ Sec. 6 Twp. 30 R 4


Well No. 1 - Gilmer Farm
Vernon O. G. + Rotana Company

760 Ft. from N. Line

_____ Ft. from S. Line

_____ Ft. from E. Line

990 Ft. from W. Line

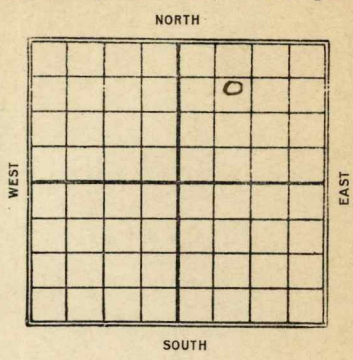

1928

Date	REPORT
5/17	R.O.G.
5/24	Rig
5/31	Rig + tools
6/7	Spudding
6/14	S.D. 600
6/21	Drlg 860
6/28	S.D. 860
7/6	Drlg - 1520
7/13	S/D 1800
7/19	Sand 1885-2010 - H.F.W. Drlg 2500.
7/26	Show oil 2385-2400 T.D. 2865 - u.R. 6"
8/1	Sand 1885-2010 H.F.W. Show oil 2385-2400 Top line 2867-3000 S. + a. 3084'

MAP NO. **11 KANSAS** SEC. 6 TWP. 30 R. 4 ^E

WELL NO. 1 Silmer
Vernon Oil & Gas & Roxana COMPANY

CONTRACTOR

SECTION PLAT

FIRST REPORTS

760 FT. FROM N. LINE
____ FT. FROM S. LINE
____ FT. FROM E. LINE
990 FT. FROM W. LINE

		o	

LOCATION Ros

RIG UP _____

DRILLING AND REMARKS:

RECORD

CASED _____ IN. _____ FT.
SAND _____
GAS _____
OIL _____
TOTAL DEPTH _____

PRODUCTION

1ST 24 HRS. NAT. _____
1ST 24 HRS. AFTER SHOT _____
GAS _____ CU. FT.
DRY HOLE _____
ABANDONED _____

DATE

MAY 17 1928

CHAS. L. SHERWOOD

192

SCOUT

Cowley

MAP NO. 11 KANSAS SEC. 6 TWP. 30 R. 4

WELL NO. 1 Gilmer

Vernon & Roxana COMPANY

CONTRACTOR

COMPLETED

SECTION PLAT

760 FT. FROM N. LINE

FT. FROM S. LINE

FT. FROM E. LINE

990 FT. FROM W. LINE

ABANDONED

		0	

LOCATION _____

RIG UP _____

DRILLING AND REMARKS:

Logs 1885-2010' HW
 Show at 2385-2400'
 TL 2967-3000'

Dqa 3084' HW

RECORD

CASED _____ IN. _____ FT.

SAND _____

GAS _____

OIL _____

TOTAL DEPTH 3084'

PRODUCTION

1ST 24 HRS. NAT. _____

1ST 24 HRS. AFTER SHOT _____

GAS _____ CU. FT.

DRY HOLE

ABANDONED

DATE

AUG 1 1928

CHAS. L. SHERWOOD

192

SCOUT

Cowley

K11

KANSAS

MAP NO. _____ SEC. 6 TWP. 30S R. 4E

WELL NO. 1 Palmer

Upton - Royan COMPANY

CONTRACTOR

ABANDONED

SECTION PLAT

		0	

_____ FT. FROM N. LINE

_____ FT. FROM S. LINE

_____ FT. FROM E. LINE

_____ FT. FROM W. LINE

LOCATION _____

RIG UP _____

DRILLING AND REMARKS:

RECORD

CASED _____ IN. _____ FT.

SAND _____

GAS _____

OIL _____

TOTAL DEPTH 3084

PRODUCTION

1ST 24 HRS. NAT. _____

1ST 24 HRS. AFTER SHOT _____

GAS _____ CU. FT.

DRY HOLE /

ABANDONED /

DATE

8/1

192 8

SCOUT