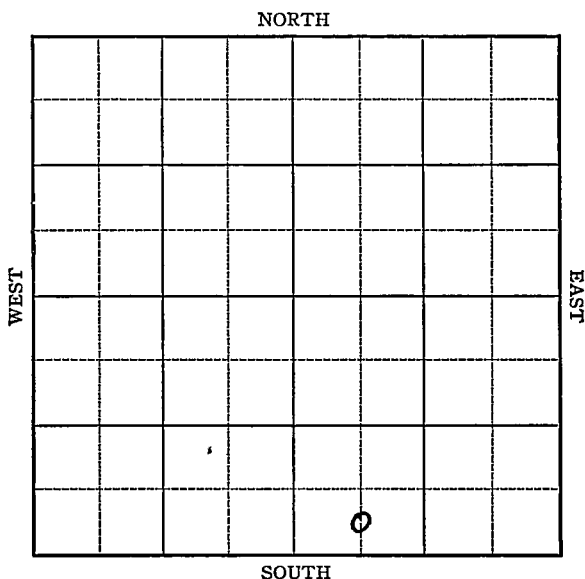


Barton

KANSAS

Section 5 Township 16 Range 13NWell No. 4 KosarCompany Cities Service Oil

Sec. 5 Twp. 16 R. 13-W

Well No. #4 Kosar Farm

Cities-Service Oil Company

(Trapp)


Ft. from N. Line

330 Ft. from S. Line

Ft. from E. Line

660 Ft. from W. Line

Elev. 1928

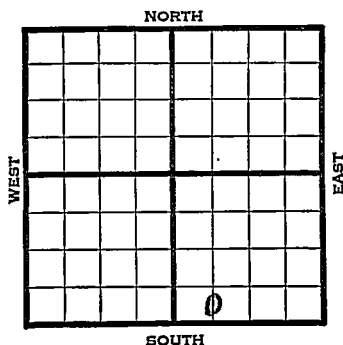[illegible]

Map No. _____ Sec. 5 Twp. 16 R. 13W

Well No. 4 Kosar

Cities Service Oil Company

FIRST REPORT Contractor

C S L SW SE

_____ Ft. from N. Line

330 _____ Ft. from S. Line

_____ Ft. from E. Line

660 _____ Ft. from W. Line

SECTION PLAT

TRAPP POOL

RECORD

Location _____

Cased _____ in., _____ ft.

Rig up _____

Sand _____

Drilling and Remarks:

Gas _____

Derrick

Oil _____

Total Depth _____

PRODUCTION

1st 24 hrs. Nat. _____

1st 24 hrs. after shot _____

Gas _____ Cu. Ft.

Dry Hole _____

Abandoned _____

Date

JUN 18 1941 19 S. J. LEWIS Scout

Map No. _____ Sec. 5 Twp. 16 R. 13WWell No. 4 KosarCities Service Oil CompanyABANDONED Contractor

C S L SW SE

____ Ft. from N. Line

330 Ft. from S. Line

____ Ft. from E. Line

660 Ft. from W. Line

TRAPP POOL

SECTION PLAT

Location _____

Rig up _____

Drilling and Remarks:

Ar 8397Water ;

RECORD

Cased _____ in., _____ ft.

Sand _____

Gas _____

Oil _____

Total Depth 3420

PRODUCTION

1st 24 hrs. Nat. _____

1st 24 hrs. after shot _____

Gas _____ Cu. Ft.

Dry Hole ✓

Abandoned _____

Date

JUL 9 1941 19S. J. LEWIS

Scout