


Section 11 Township 30 Range 4 E

Well No. #43 Rock Unit

Company Stelbar Oil

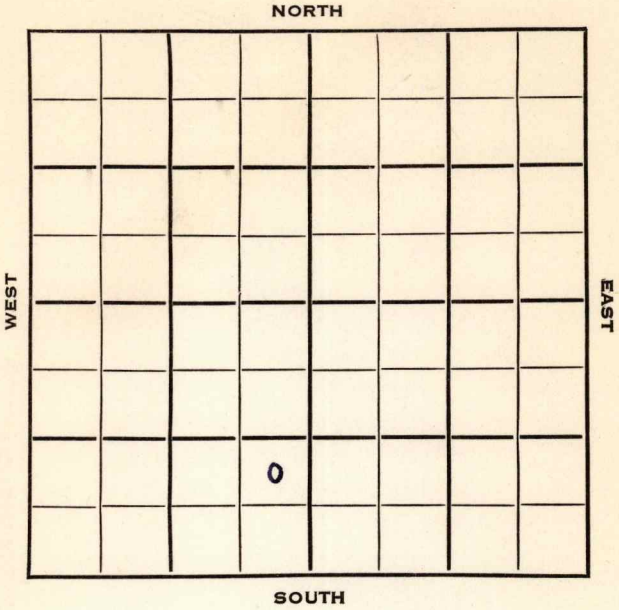

Cowley

KANSAS



Sec. 11 Twp. 30 R. 4 E

Well No. # 43 Rock Unit Farm

Stelbar Oil Company

Contractor


Ft. from N. Line

990 Ft. from S. Line

330 Ft. from E. Line

Ft. from W. Line

NE SE SW

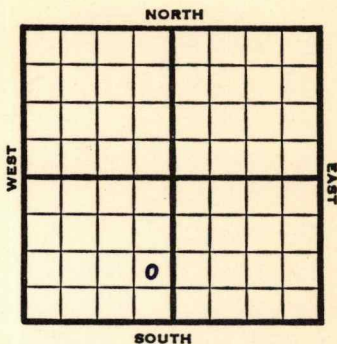

1953

Elev. 1215'

REPORT

6/10

Spud 6-4-53
8" @ 78
Drlg. 965'

7/15

Spud 6-4-53
Oil Well
TD 2753'
8" @ 78'
KC 2202, Bart 2739
TD 2753'
CO to 2753
FU 375' wtr.
Comp. Waiting on water flood.

COMPLETED

